

901030215

VILLAGE AT CORDATA NORTH SIDE PHASE I

A PORTION OF PARCEL 4

"CORDATA SPECIFIC BINDING SITE PLAN NO. 1"

SECTION 12, TOWNSHIP 38 NORTH, RANGE 2 EAST, OF W.M.

UNIT	APPROXIMATE SQUARE FEET - UNIT	SQUARE FEET - LIMITED COMMON AREA	UNIT	APPROXIMATE SQUARE FEET - UNIT	SQUARE FEET - LIMITED COMMON AREA
Building Unit M1	Living Area = 1870 sq. ft. Garage = 424 sq. ft.	5122 sq. ft.			
Building Unit K2	Living Area = 1643 sq. ft. Garage = 527 sq. ft.	2328 sq. ft.	Building Unit J12	Living Area = 1350 sq. ft. Garage = 500 sq. ft.	3123 sq. ft.
Building Unit H3	Living Area = 1295 sq. ft. Garage = 443 sq. ft.	3223 sq. ft.	Building Unit J13	Living Area = 1355 sq. ft. Garage = 494 sq. ft.	3199 sq. ft.
Building Unit M4	Living Area = 1786 sq. ft. Garage = 519 sq. ft.	3861 sq. ft.	Building Unit M14	Living Area = 1780 sq. ft. Garage = 499 sq. ft.	3705 sq. ft.
Building Unit K5	Living Area = 1659 sq. ft. Garage = 499 sq. ft.	5513 sq. ft.	Building Unit H15	Living Area = 1210 sq. ft. Garage = 442 sq. ft.	2942 sq. ft.
Building Unit K6	Living Area = 1644 sq. ft. Garage = 498 sq. ft.	3197 sq. ft.	Building Unit G16	Living Area = 1121 sq. ft. Garage = 430 sq. ft.	3030 sq. ft.
Building Unit M7	Living Area = 1723 sq. ft. Garage = 519 sq. ft.	3613 sq. ft.	Building Unit M17	Living Area = 1789 sq. ft. Garage = 502 sq. ft.	3747 sq. ft.
Building Unit L8	Living Area = 1590 sq. ft. Garage = 482 sq. ft.	4594 sq. ft.	Building Unit L18	Living Area = 1590 sq. ft. Garage = 483 sq. ft.	3227 sq. ft.
Building Unit L9	Living Area = 1607 sq. ft. Garage = 478 sq. ft.	4488 sq. ft.	Building Unit M19	Living Area = 1814 sq. ft. Garage = 500 sq. ft.	2224 sq. ft.
Building Unit G10	Living Area = 1119 sq. ft. Garage = 437 sq. ft.	2807 sq. ft.	Building Unit L20	Living Area = 1588 sq. ft. Garage = 482 sq. ft.	2185 sq. ft.
Building Unit H11	Living Area = 1205 sq. ft. Garage = 452 sq. ft.	2669 sq. ft.	Building Unit L21	Living Area = 1624 sq. ft. Garage = 484 sq. ft.	2948 sq. ft.



901030215

VILLAGE AT CORDATA · NORTH SIDE · PHASE I

A PORTION OF PARCEL 4
 "CORDATA SPECIFIC BINDING SITE PLAN NO. 1"
 SECTION 12, TOWNSHIP 38 NORTH, RANGE 2 EAST, W.M.

SURVEYOR'S CERTIFICATE

I, RAYMOND D. WEDEN, BEING FIRST DULY SWORN ON OATH, DEPOSE AND SAY: THAT I AM A REGISTERED LAND SURVEYOR WITH THE STATE OF WASHINGTON. I HEREWITH VERIFY AND STATE THAT THE SET OF PLANS ATTACHED HERETO ACCURATELY DEPICT THE LOCATION AND DIMENSIONS OF THE APARTMENT UNIT AS BUILT WITH RESPECT TO THOSE CERTAIN CONDOMINIUMS KNOWN AS "VILLAGE AT CORDATA, NORTH SIDE, PHASE I", AND WHICH SAID BUILDINGS ARE LOCATED WITH REFERENCE TO THE SURVEY MAP RECORDED SIMULTANEOUSLY WITH THE DECLARATION OF CONDOMINIUM WITH RESPECT TO SAID "VILLAGE AT CORDATA, NORTH SIDE, PHASE I", IS BASED UPON AN ACTUAL SURVEY OF THE PROPERTY, THAT THE CORNERS WERE SET IN ACCORDANCE WITH THE LEGAL DESCRIPTION, THAT THE COURSES AND DISTANCES ARE SHOWN CORRECTLY HEREON AND THAT I HAVE TO THE BEST OF MY ABILITY, COMPLIED WITH THE PROVISIONS OF SECTION 64.32.100 OF THE "HORIZONTAL PROPERTY REGIMES ACT" OF THE STATE OF WASHINGTON.

ACKNOWLEDGEMENT

STATE OF WASHINGTON)) SS
 COUNTY OF WHATCOM)

I, RAYMOND D. WEDEN, BEING DULY SWORN UPON OATH, DEPOSE AND SAY: I AM THE ABOVE NAMED LAND SURVEYOR, I HAVE READ THE FOREGOING LAND SURVEYOR'S CERTIFICATE, KNOW THE CONTENTS THEREOF AND BELIEVE THE SAME TO BE TRUE.

Raymond D. Weden 10-23-90
 RAYMOND D. WEDEN, P.L.S. NO. 18928
 WEDEN ENGINEERING, INC.

DEDICATION

KNOWN ALL MEN BY THESE PRESENTS, THAT WE THE UNDERSIGNED OWNERS IN FEE SIMPLE AND/OR AS MORTGAGEES OF THE PROPERTY HEREBY PLATTED, HEREBY DECLARE THIS PLAT AND DEDICATE THE SAME FOR CONDOMINIUM PURPOSES.

THIS PLAT OR ANY PORTION THEREOF SHALL BE RESTRICTED BY THE TERMS OF THE DECLARATION FILED UNDER WHATCOM DEPARTMENT OF RECORDS AND ELECTIONS FILE NO. 901030216, AND RECORDED IN THE RECORDS OF WHATCOM COUNTY, WASHINGTON.

IN WITNESS WHEREOF WE HAVE SET OUR HANDS AND SEALS.

James A. Wynstra
 JAMES A. WYNSTRA, PRESIDENT
 TULIP FINANCIAL SERVICES, INC.

ACKNOWLEDGEMENT


STATE OF WASHINGTON)) SS
 COUNTY OF WHATCOM)

ON THIS 16 DAY OF OCTOBER, 1990, BEFORE ME THE UNDERSIGNED, A NOTARY PUBLIC IN AND FOR THE STATE OF WASHINGTON, PERSONALLY APPEARED JAMES A. WYNSTRA, REPRESENTING TULIP FINANCIAL SERVICES, INC. TO ME KNOWN TO BE THE INDIVIDUAL(S) DESCRIBED IN AND WHO EXECUTED THE DEDICATION HEREON, AND ACKNOWLEDGED THAT HE SIGNED THE SAME AS HIS FREE AND VOLUNTARY ACT AND DEED, FOR THE USES AND PURPOSES HEREIN MENTIONED.

WITNESS MY HAND AND OFFICIAL SEAL THE DAY AND YEAR FIRST ABOVE WRITTEN

Richard E. Priev

NOTARY PUBLIC IN AND FOR THE STATE OF WASHINGTON
 RESIDING AT CORVALLIS

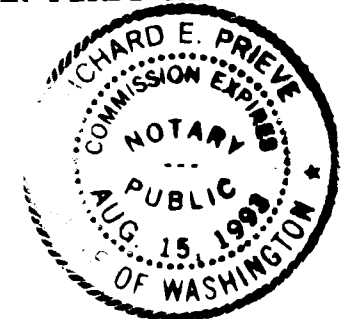AUDITOR'S CERTIFICATE

I HEREBY CERTIFY THAT THIS CONDOMINIUM PLAT OF THE "VILLAGE AT CORDATA, NORTH SIDE, PHASE I" WAS FILED FOR RECORD IN THE OFFICE OF THE AUDITOR OF WHATCOM COUNTY, WASHINGTON, AT THE REQUEST OF Whatcom Land Title Co. ON THIS 30 DAY OF October, 1990, AT 0 O'CLOCK A.M., AND THAT IT IS RECORDED IN BOOK 9 OF CONDOMINIUM PLATS, PAGES 48-74 OF THE RECORDS OF WHATCOM COUNTY, WASHINGTON.

Shirley Forslof - Rita Westford
 AUDITOR, WHATCOM COUNTY, WASHINGTON

TREASURER'S CERTIFICATE

I, BARBARA J. Cory, TREASURER OF WHATCOM COUNTY, WASHINGTON, DO HEREBY CERTIFY THAT ALL TAXES REQUIRED BY LAW TO BE PAID UPON THAT PORTION OF THE REAL ESTATE EMBRACED BY THIS CONDOMINIUM, "VILLAGE AT CORDATA, NORTH SIDE, PHASE I", AND ALL THE DELINQUENT ASSESSMENTS HAVE BEEN FULLY PAID, AS SHOWN IN THE RECORDS OF MY OFFICE.

Judy Reed Deputy
 TREASURER, WHATCOM COUNTY, WASHINGTON

10-30-90
 DATE

901030215

VILLAGE AT CORDATA · NORTH SIDE · PHASE I

A PORTION OF PARCEL 4

"CORDATA SPECIFIC BINDING SITE PLAN NO. 1"
SECTION 12, TOWNSHIP 38 NORTH, RANGE 2 EAST, W.M.

LEGAL DESCRIPTION


THAT PORTION OF PARCEL 4, "CORDATA SPECIFIC BINDING SITE PLAN NO. 1", AS PER THE MAP THEREOF RECORDED IN VOLUME 1 OF BINDING SITE PLANS, PAGES 13 TO 15, INCLUSIVE, UNDER AUDITOR'S FILE NO. 1598964, RECORDS OF WHATCOM COUNTY, WASHINGTON, BEING MORE PARTICULARLY DESCRIBED AS FOLLOWS:

COMMENCING AT THE SOUTHWEST CORNER OF SAID PARCEL 4; THENCE SOUTH 89 DEGREES 40' 24" EAST ALONG THE SOUTH LINE OF SAID PARCEL 4 AND THE NORTHERLY MARGIN OF JUNE ROAD, 116.83 FEET TO THE TRUE POINT OF BEGINNING; THENCE NORTH 42 DEGREES 28' 00" EAST, 137.64 FEET TO A POINT ON THE ARC OF A CURVE HAVING A CENTRAL ANGLE OF 18 DEGREES 10' 14" AND A CENTER BEARING NORTH 10 DEGREES 32' 04" EAST, 130.00 FEET; THENCE NORTHWESTERLY ALONG THE ARC OF SAID CURVE 41.23 FEET; THENCE NORTH 28 DEGREES 42' 18" EAST, 40.00 FEET TO A POINT ON THE ARC OF A CURVE HAVING A CENTRAL ANGLE OF 49 DEGREES 30' 13" AND A CENTER BEARING NORTH 28 DEGREES 42' 18" EAST, 90.00 FEET; THENCE NORTHWESTERLY ALONG THE ARC OF SAID CURVE, 77.76 FEET; THENCE NORTH 72 DEGREES 05' 00" EAST, 101.05 FEET; THENCE NORTH 8 DEGREES 32' 00" EAST, 226.98 FEET; THENCE SOUTH 85 DEGREES 10' 00" EAST, 267.14 FEET TO A POINT ON THE ARC OF A CURVE HAVING A CENTRAL ANGLE OF 36 DEGREES 17' 06" AND A CENTER BEARING SOUTH 81 DEGREES 45' 30" WEST, 90.00 FEET; THENCE SOUTHERLY ALONG THE ARC OF SAID CURVE, 57.00 FEET; THENCE SOUTH 61 DEGREES 57' 24" EAST, 40.00 FEET; THENCE SOUTH 28 DEGREES 02' 36" WEST, 47.10 FEET; THENCE SOUTH 75 DEGREES 18' 39" EAST, 113.17 FEET TO A POINT ON THE ARC OF A CURVE HAVING A CENTRAL ANGLE OF 38 DEGREES 15' 09" AND A CENTER BEARING SOUTH 51 DEGREES 25' 14" EAST, 340.00 FEET; THENCE SOUTHERLY ALONG THE ARC OF SAID CURVE, 226.99 FEET; THENCE SOUTH 0 DEGREES 19' 36" WEST, 67.27 FEET TO A POINT ON THE ARC OF A TANGENTIAL CURVE TO THE RIGHT HAVING A CENTRAL ANGLE OF 90 DEGREES 00' 00" AND A CENTER BEARING NORTH 89 DEGREES 40' 24" WEST, 25.00 FEET; THENCE SOUTHWESTERLY ALONG THE ARC OF SAID CURVE 39.27 FEET; THENCE NORTH 89 DEGREES 40' 24" WEST, 437.89 FEET TO THE TRUE POINT OF BEGINNING.


SUBJECT TO ALL RESTRICTIONS, COVENANTS, AND EASEMENTS OF RECORDS.

SITUATE IN COUNTY OF WHATCOM, STATE OF WASHINGTON.

CONTAINING 169,725 SQUARE FEET, MORE OR LESS.

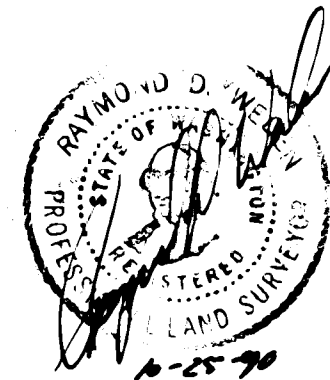

A PORTION OF PARCEL 4
"CORDATA SPECIFIC BINDING SITE PLAN NO.1"
SECTION 12, TOWNSHIP 38 NORTH, RANGE 2 EAST, OF W.M.

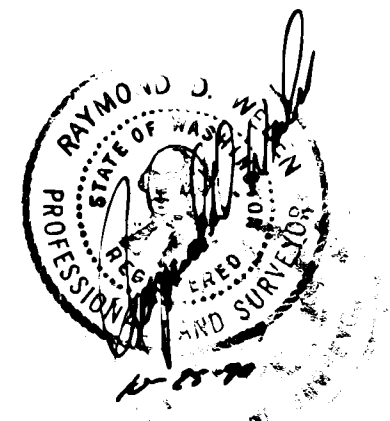

901030215

VILLAGE AT CORDATA NORTH SIDE PHASE I


A PORTION OF PARCEL 4

"CORDATA SPECIFIC BINDING SITE PLAN NO. 1"

SECTION 12, TOWNSHIP 38 NORTH, RANGE 2 EAST, OF W.M.

LEGEND

- EXISTING REBAR
- REBAR W/ "WEDEN" CAP SET
- ⊙ BRASS SURFACE MON. SET
- ⊙ EXISTING IRON PIPE
- EXISTING CONC MON

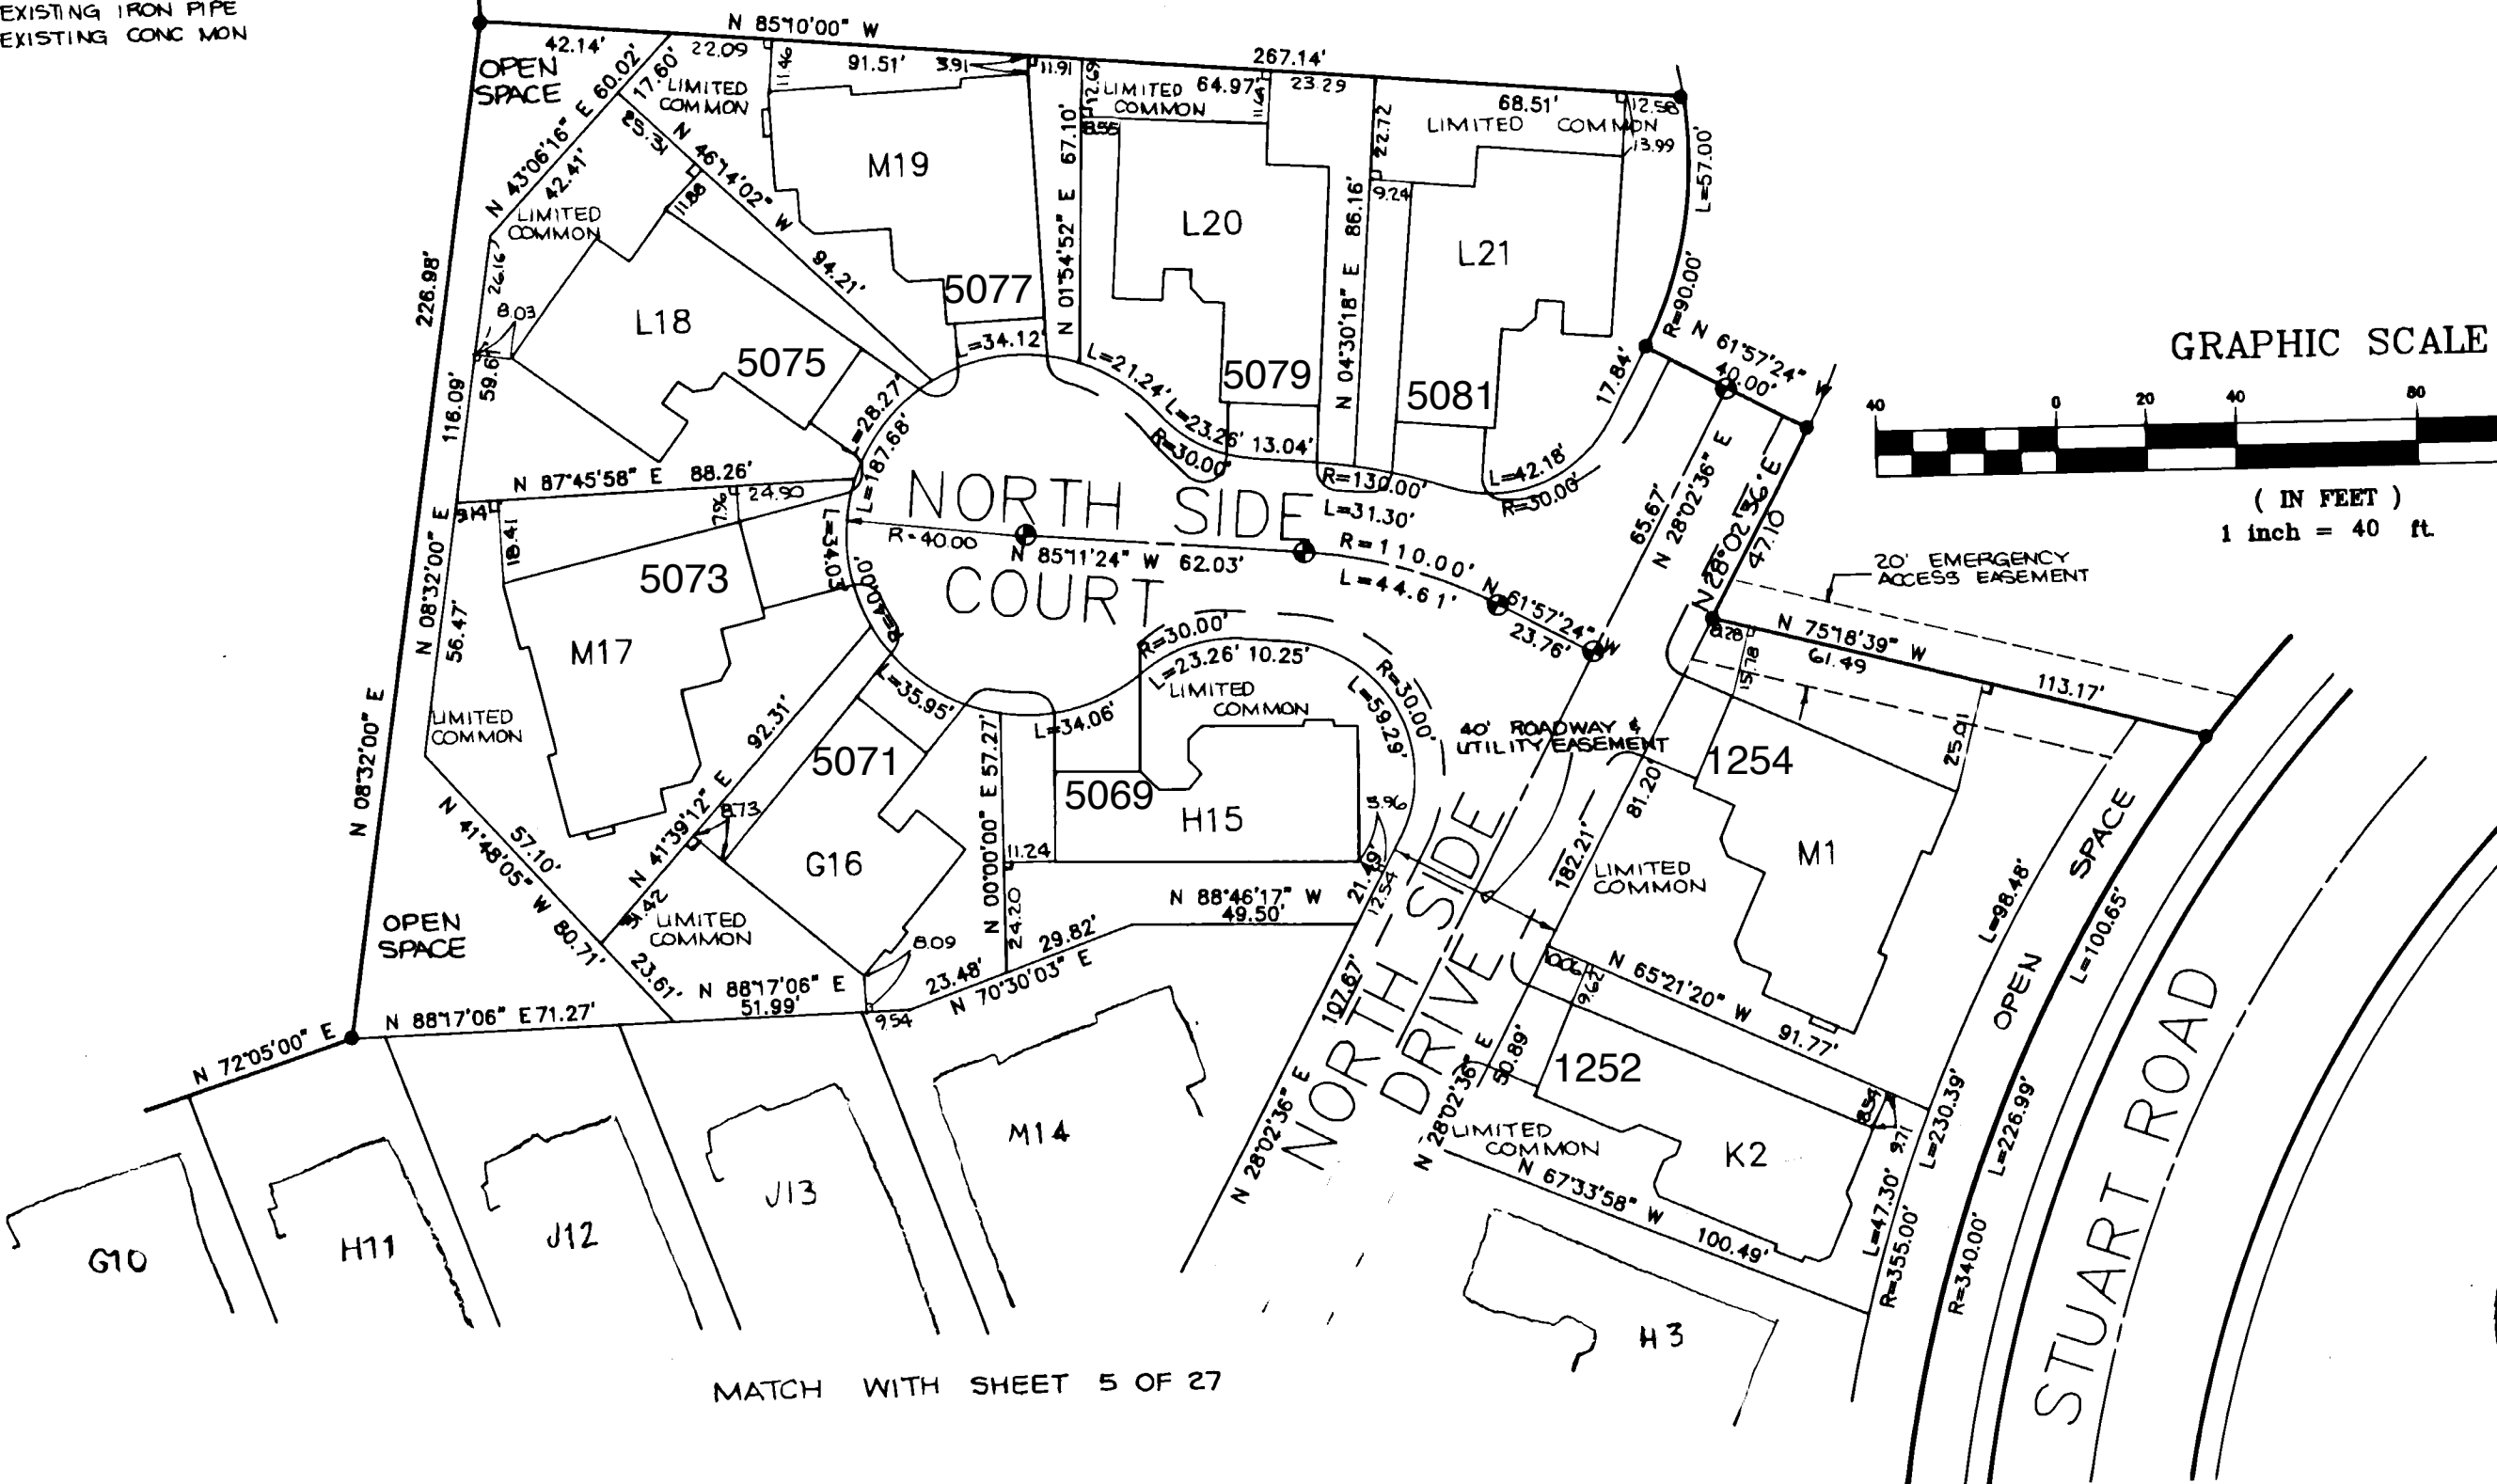

GRAPHIC SCALE



(IN FEET)
1 inch = 40 ft.

MATCH WITH SHEET 5 OF 27



901030215

VILLAGE AT CORDATA NORTH SIDE PHASE I

A PORTION OF PARCEL 4


"CORDATA SPECIFIC BINDING SITE PLAN NO. 1"

SECTION 12, TOWNSHIP 38 NORTH, RANGE 2 EAST, OF W.M.

LEGEND

- EXISTING REBAR
- REBAR W/ "WEDEN" CAP SET
- ⊙ BRASS SURFACE MON. SET
- ⊙ EXISTING IRON PIPE
- EXISTING CONC. MON.

MATCH WITH SHEET
4 OF 27


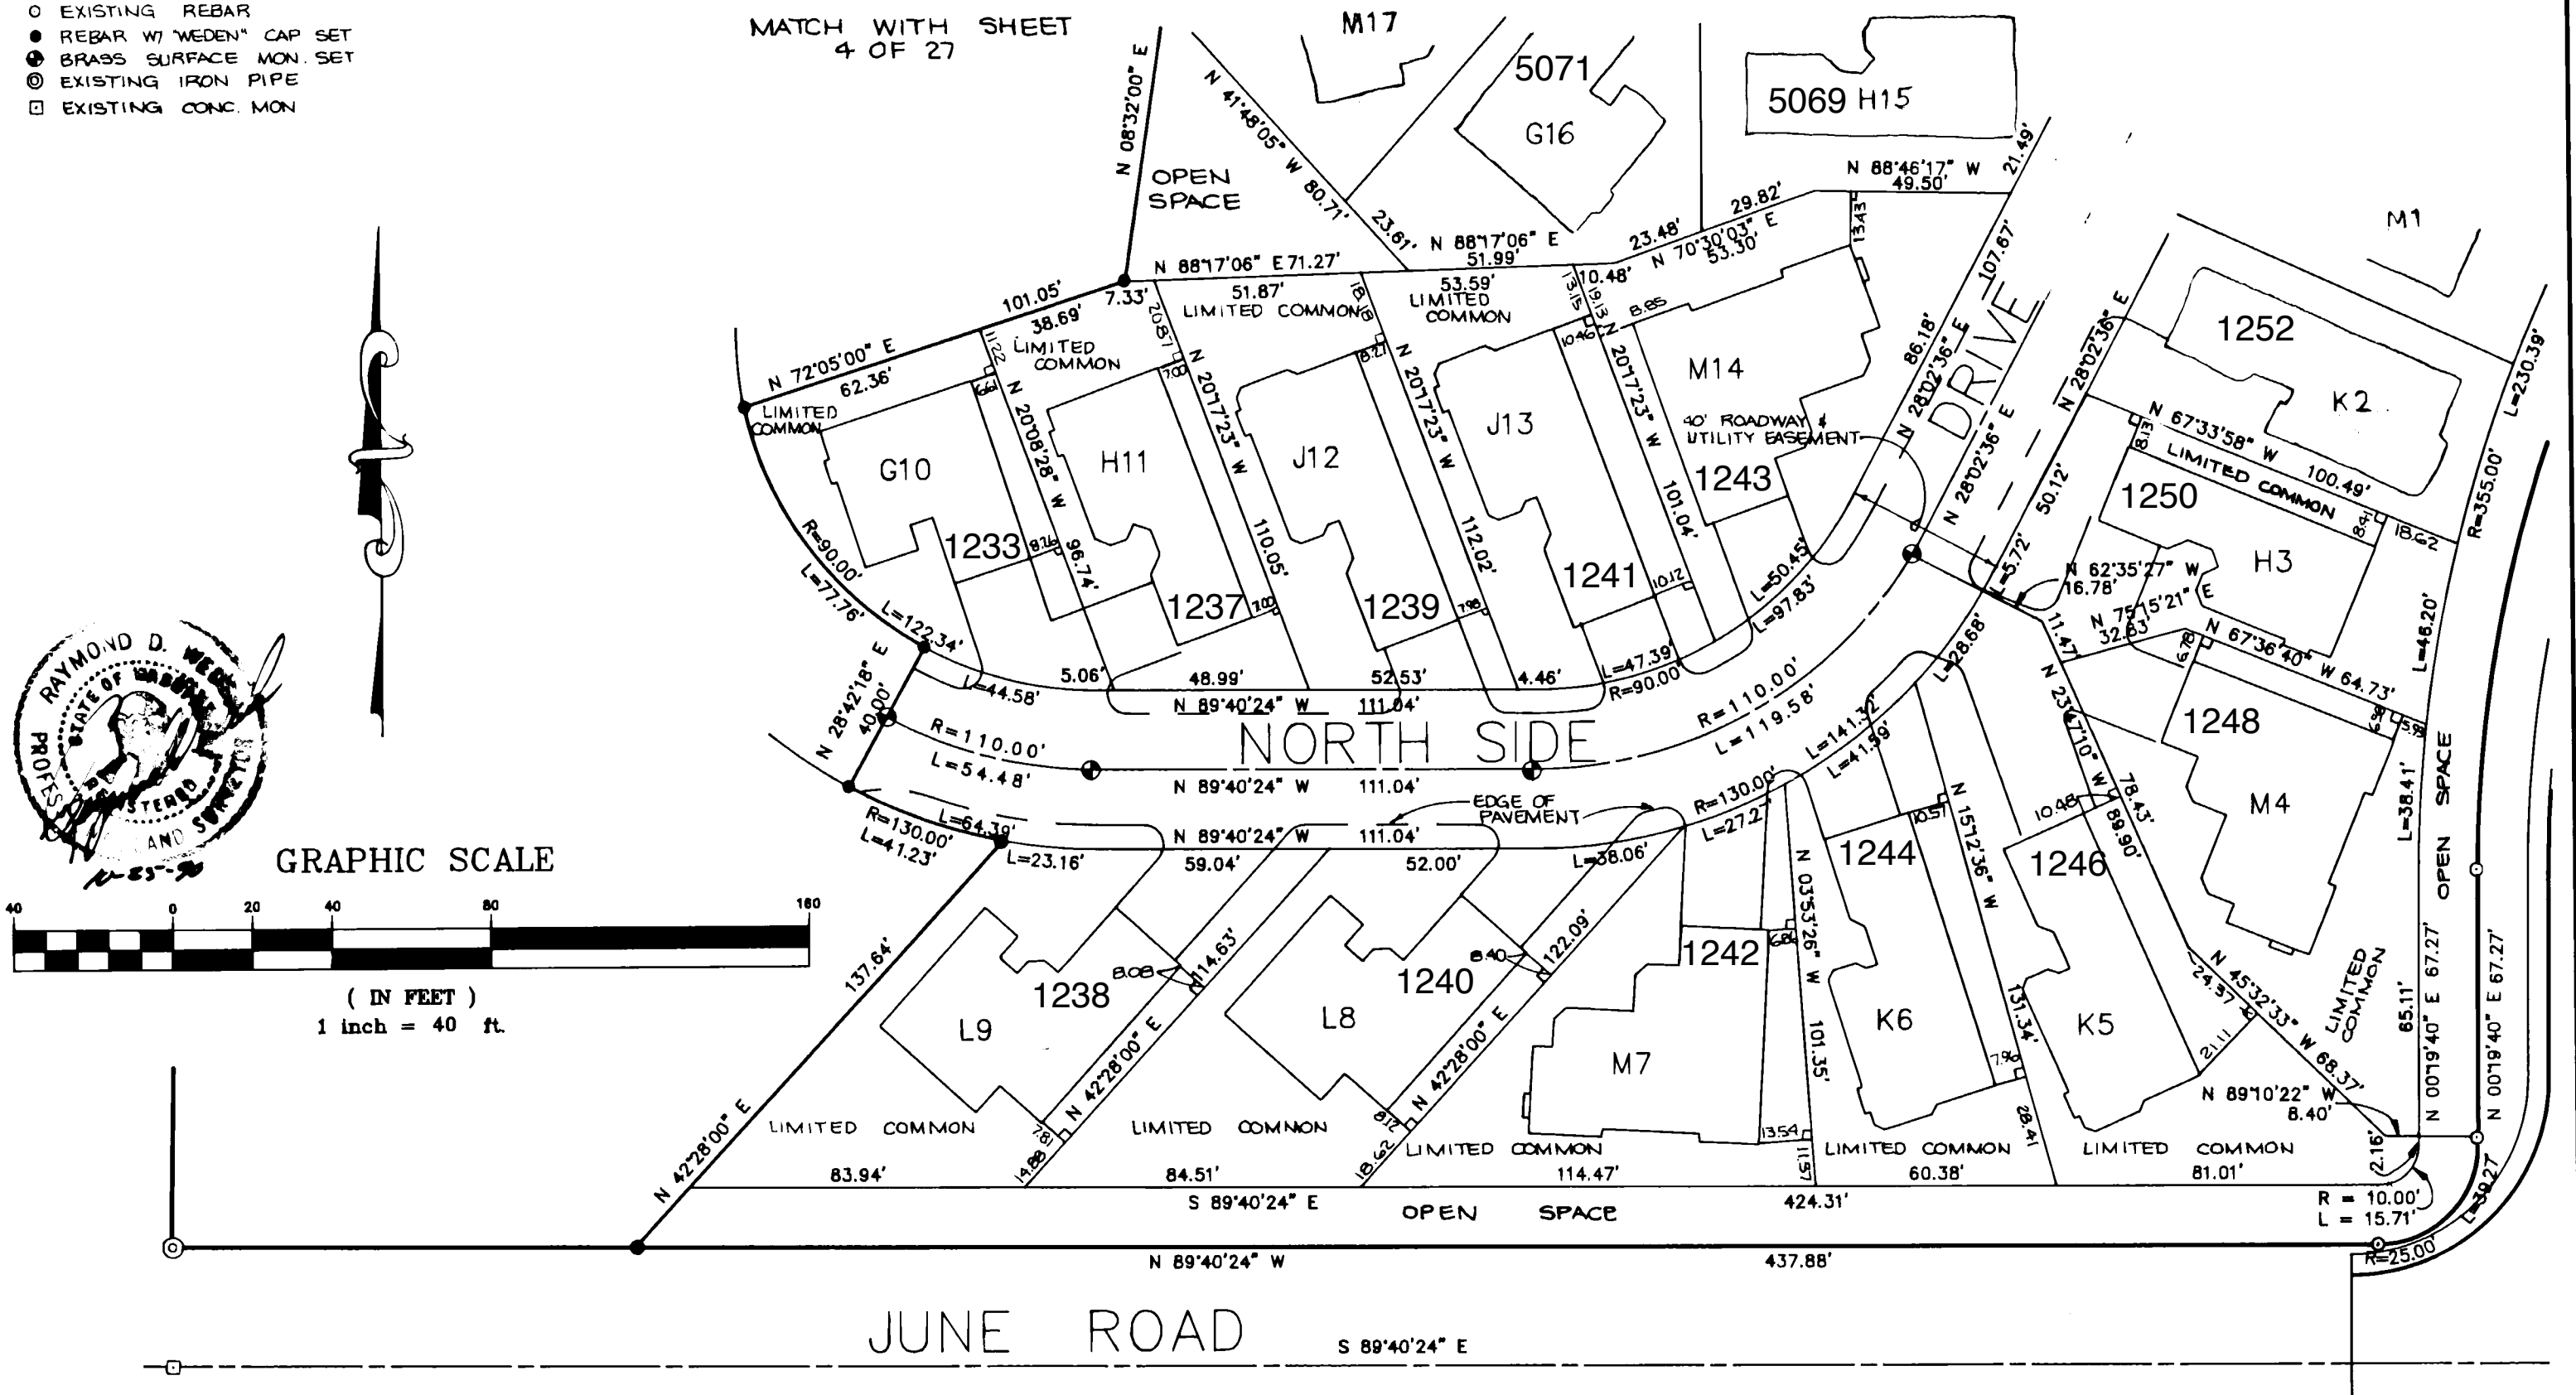


901030215


VILLAGE AT CORDATA · NORTH SIDE · PHASE I

A PORTION OF PARCEL 4
"CORDATA SPECIFIC BINDING SITE PLAN NO. 1"
SECTION 12, TOWNSHIP 38 NORTH, RANGE 2 EAST, W.M.
SCALE: 1" = 10'


BUILDING UNIT M.1

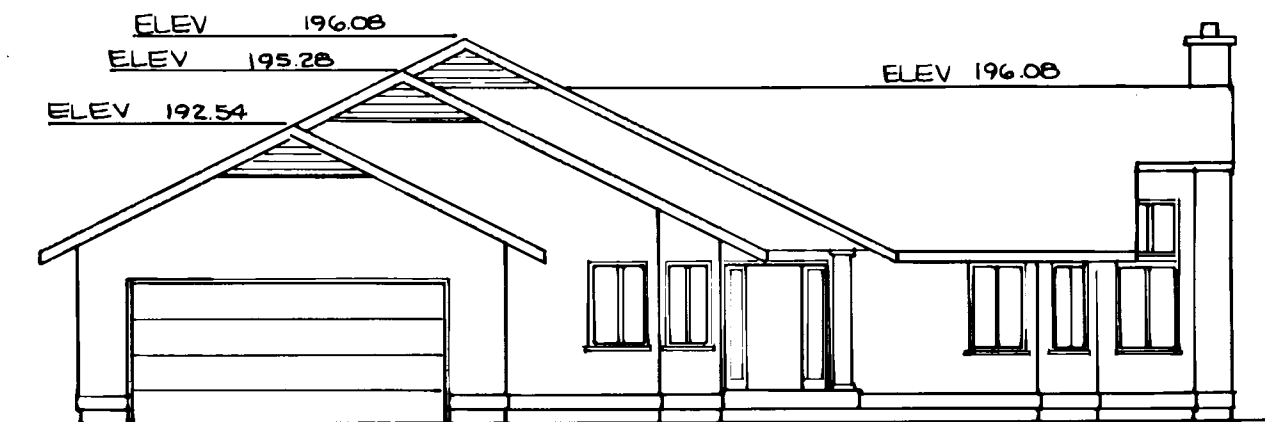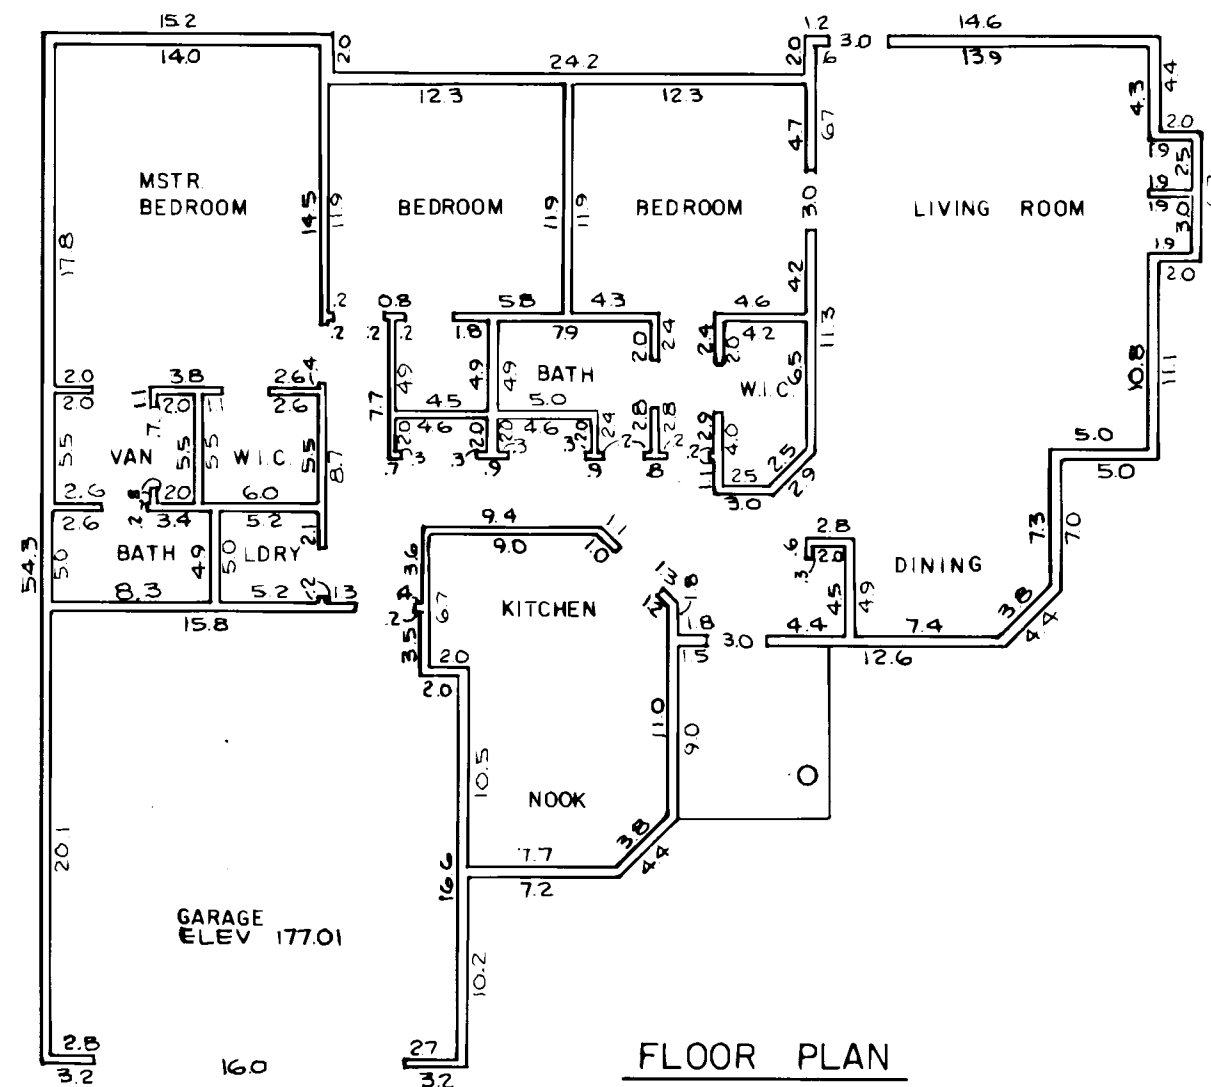


FRONT ELEVATION

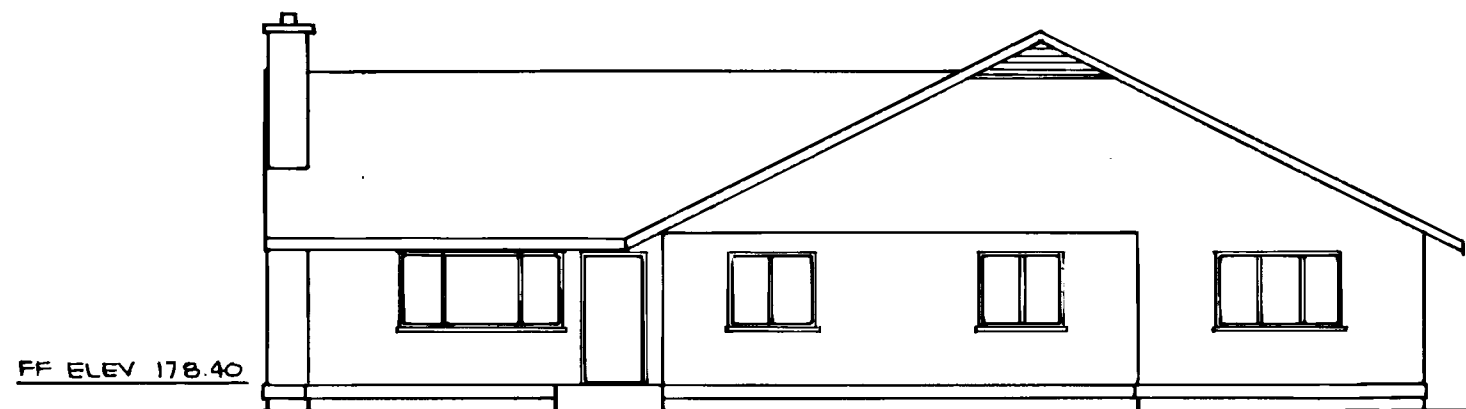

REAR ELEVATION

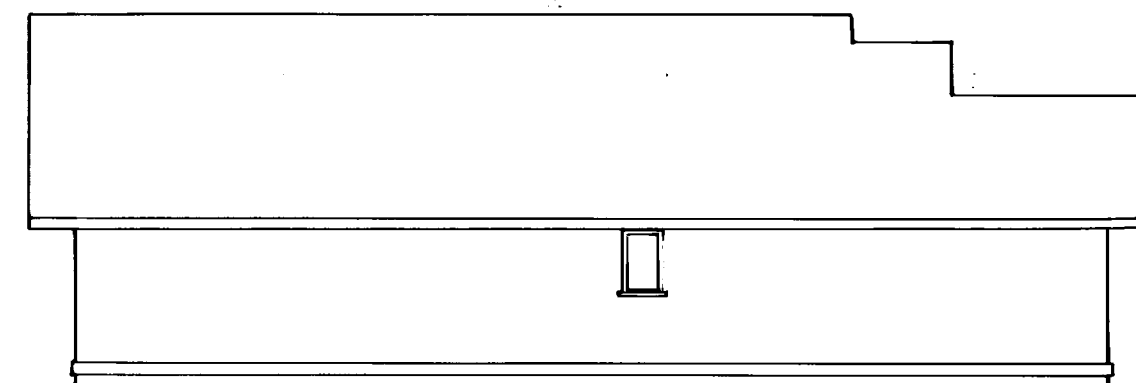

LEFT ELEVATION

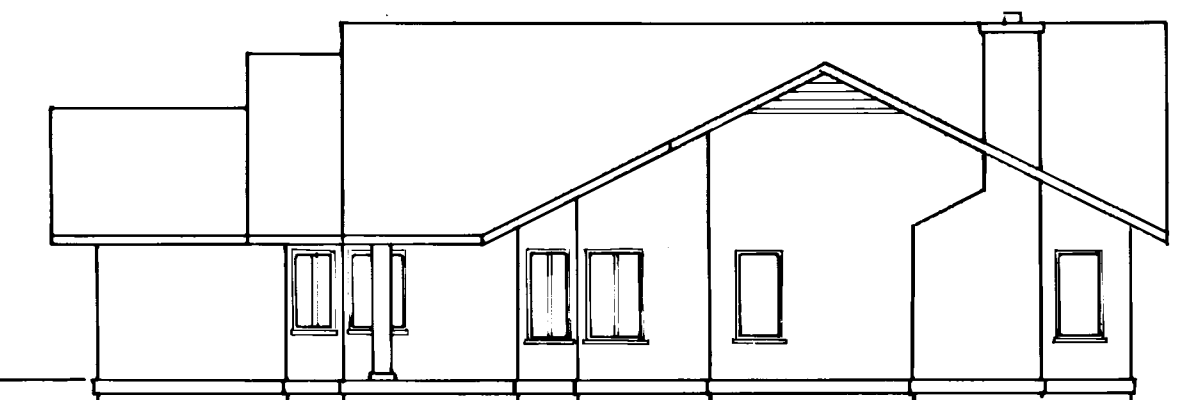

RIGHT ELEVATION

901030215

VILLAGE AT CORDATA · NORTH SIDE · PHASE I


A PORTION OF PARCEL 4

"CORDATA SPECIFIC BINDING SITE PLAN NO. 1"

SECTION 12, TOWNSHIP 38 NORTH, RANGE 2 EAST, W.M.


SCALE: 1" = 10'

BUILDING UNIT K2

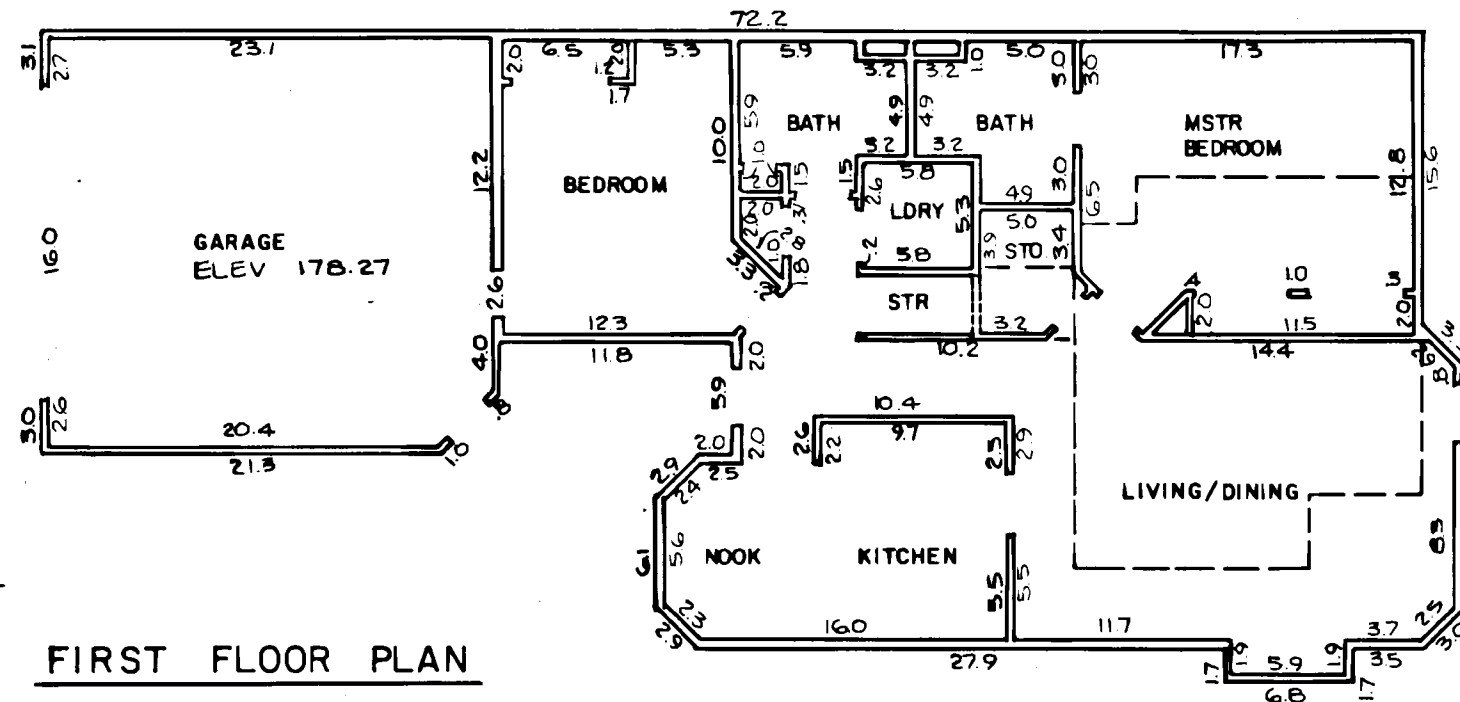

FIRST FLOOR PLAN


SECOND FLOOR PLAN

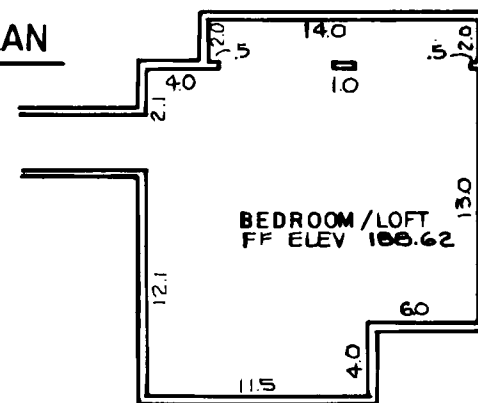


REAR ELEVATION



RIGHT ELEVATION

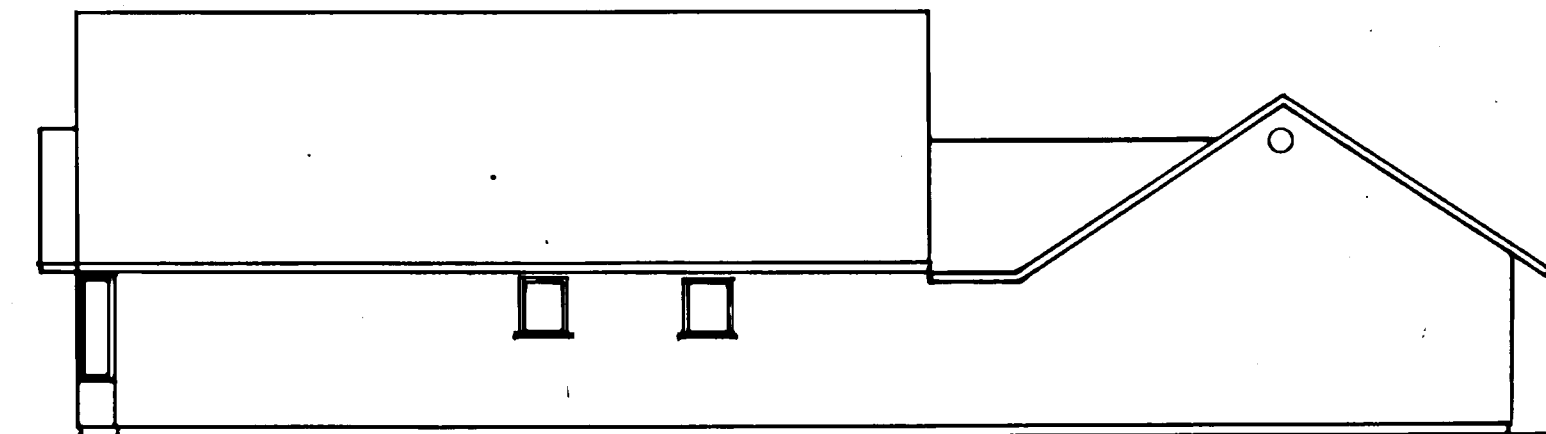

LEFT ELEVATION

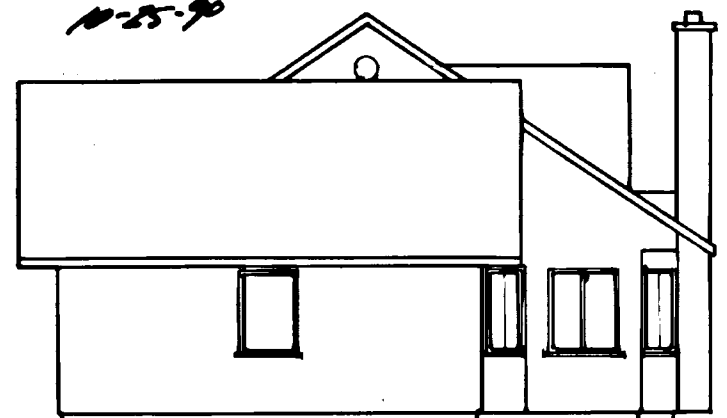

FRONT ELEVATION

901030215

VILLAGE AT CORDATA · NORTH SIDE · PHASE I.


A PORTION OF PARCEL 4

"CORDATA SPECIFIC BINDING SITE PLAN NO. 1"


SECTION 12, TOWNSHIP 38 NORTH, RANGE 2 EAST, W.M.

SCALE · 1" = 10'


BUILDING UNIT H3

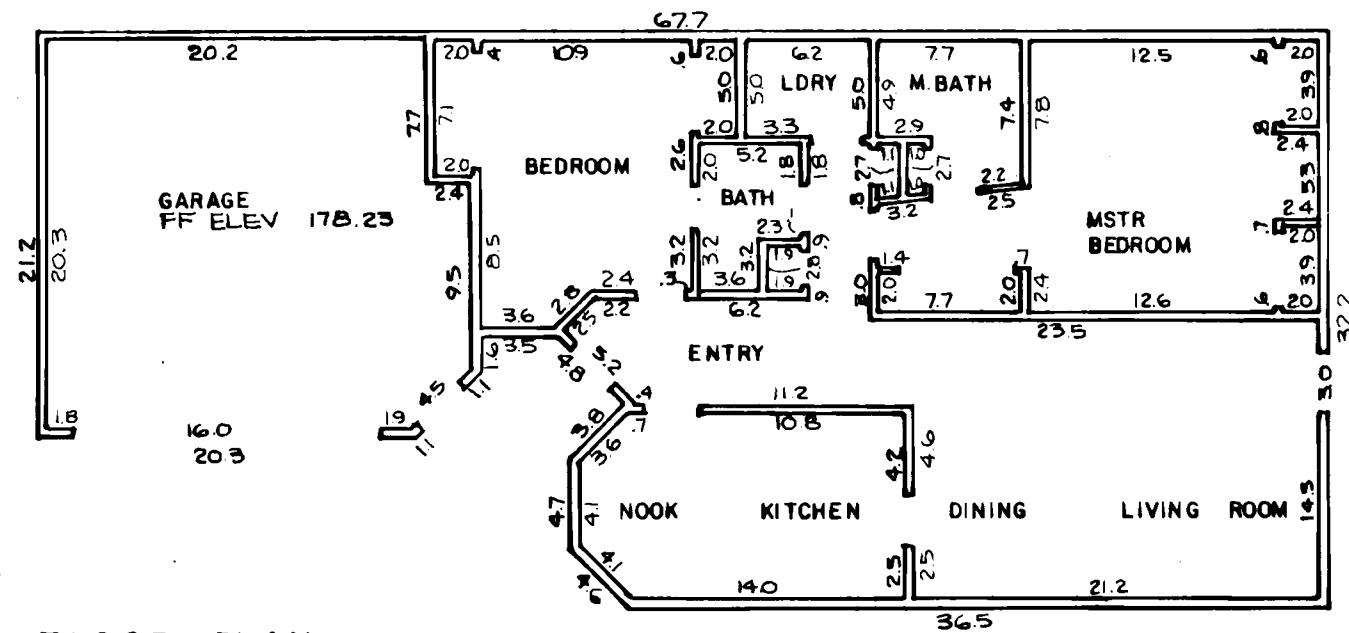

FLOOR PLAN

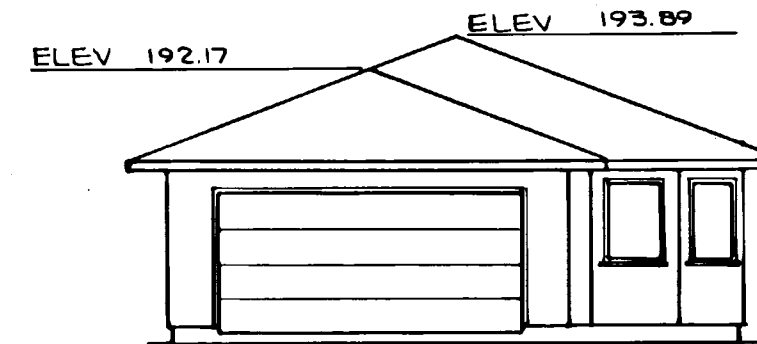


FRONT ELEVATION

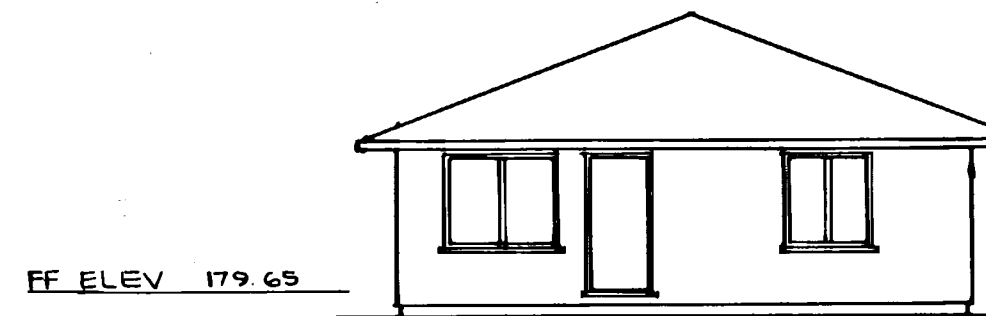

REAR ELEVATION



RIGHT ELEVATION

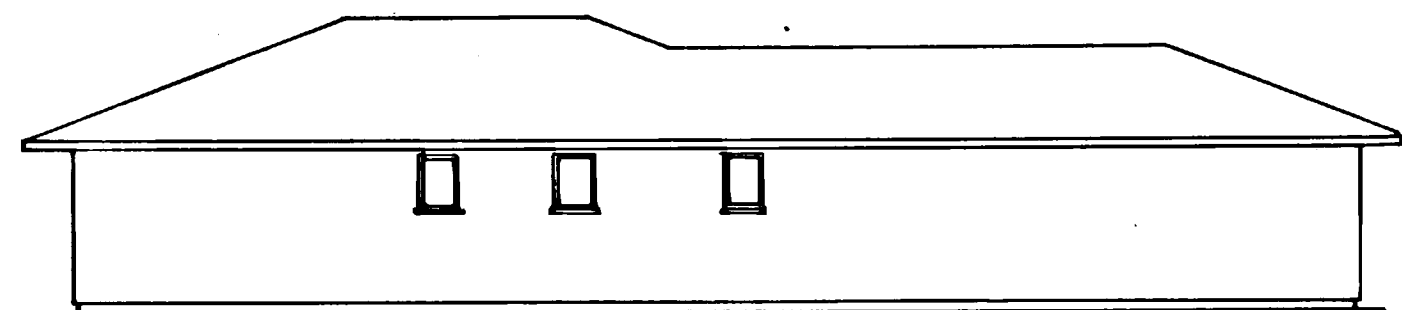


LEFT ELEVATION




SCALE : 1" = 10'

BUILDING UNIT M 4

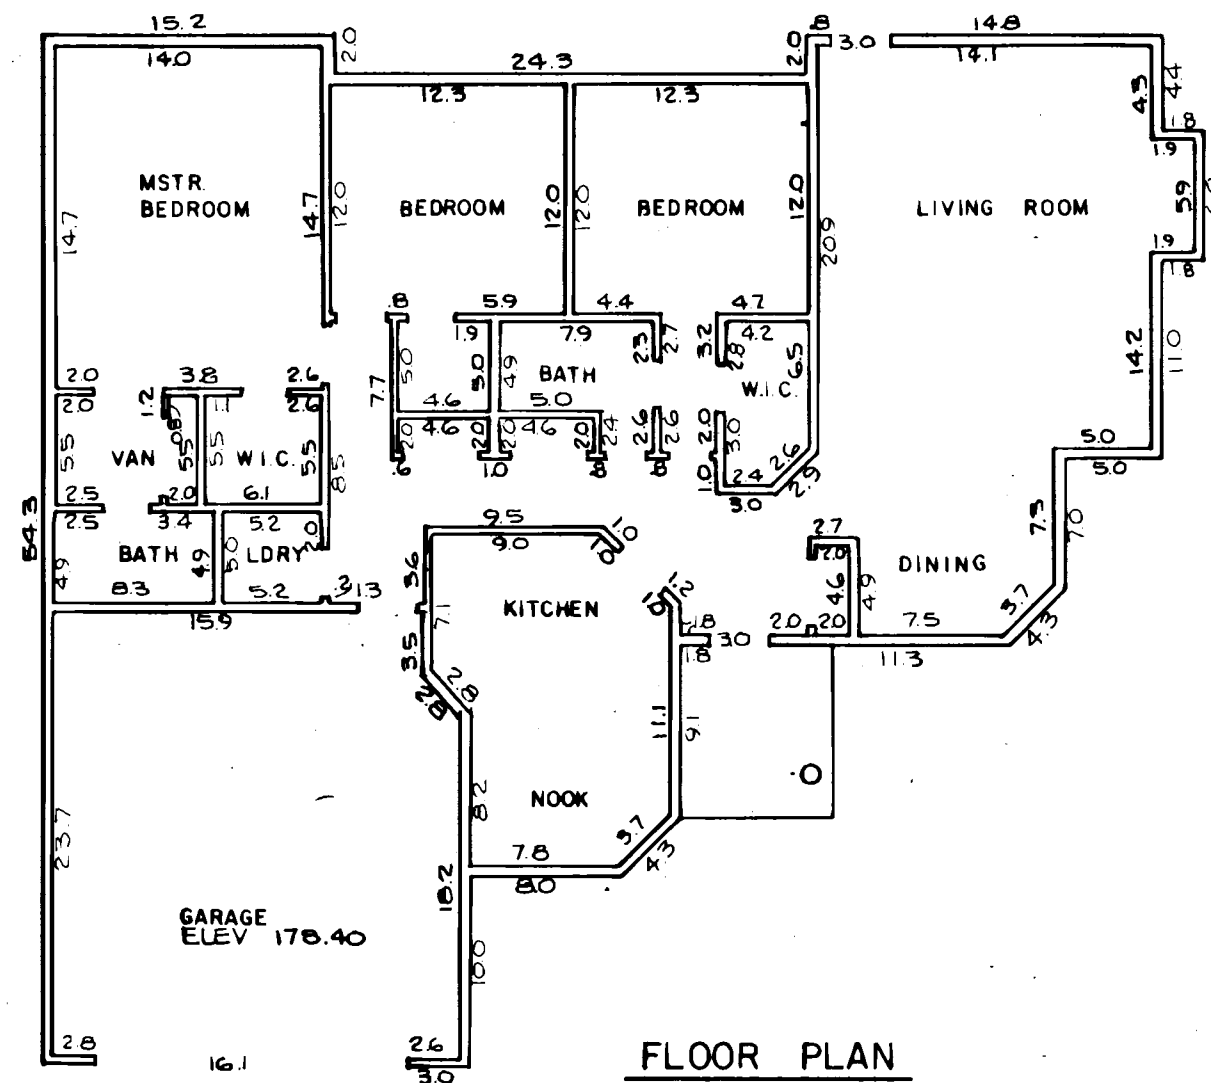


FLOOR PLAN

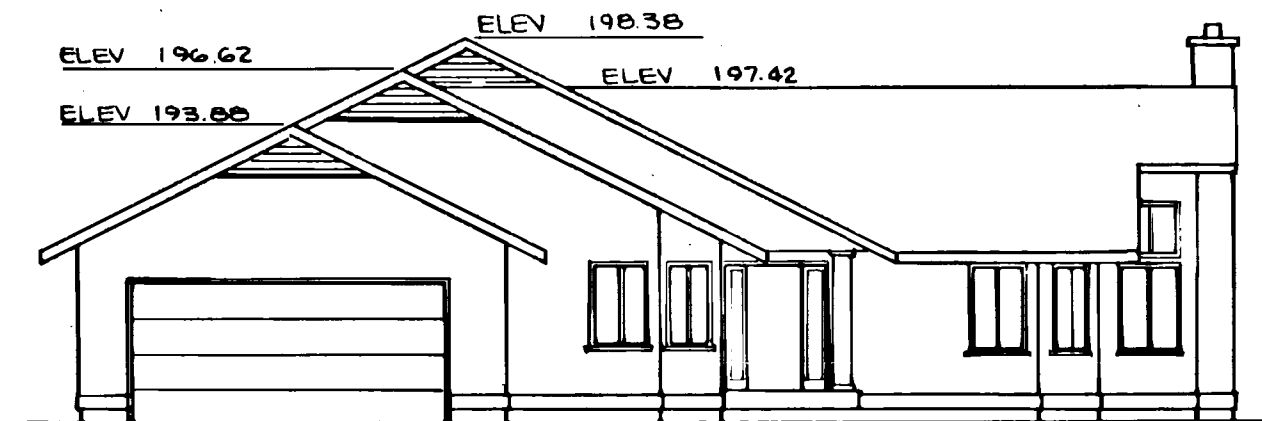


FRONT ELEVATION



REAR ELEVATION

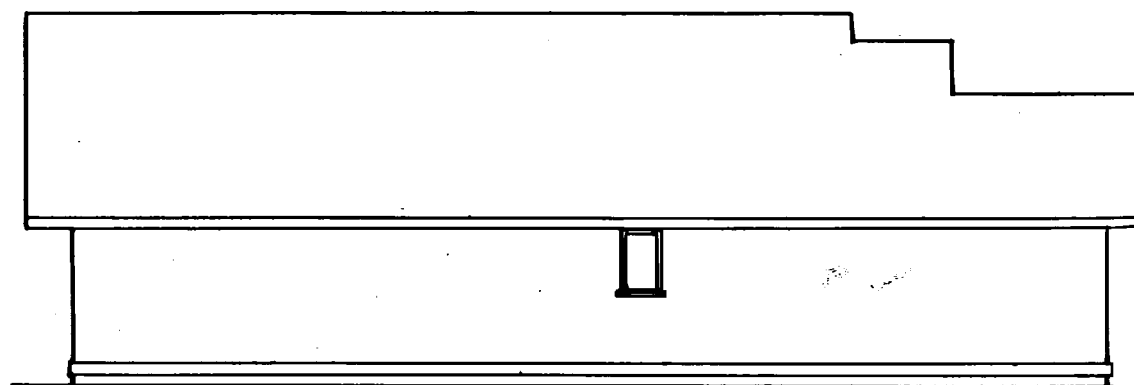

LEFT ELEVATION

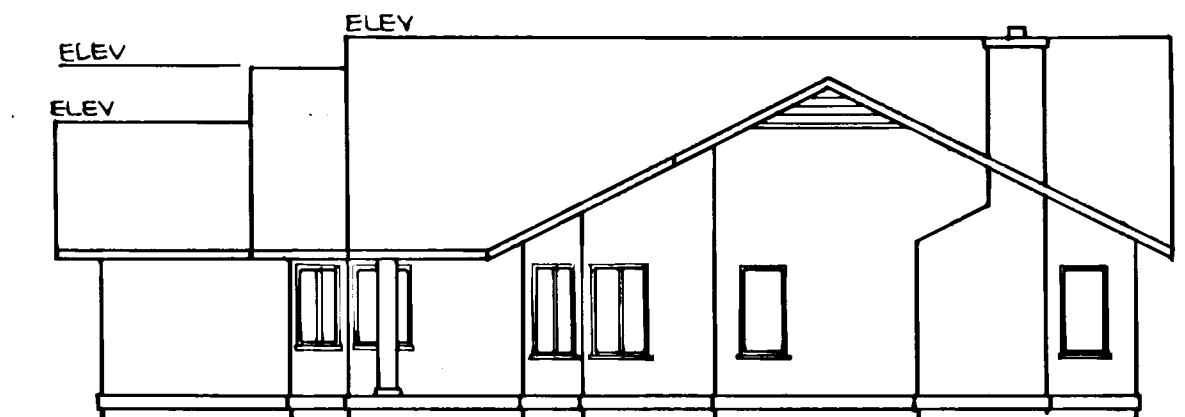

RIGHT ELEVATION

901030215

VILLAGE AT CORDATA · NORTH SIDE · PHASE I


A PORTION OF PARCEL 4

"CORDATA SPECIFIC BINDING · SITE PLAN NO. 1"



SECTION 12, TOWNSHIP 38 NORTH, RANGE 2 EAST, W.M.

SCALE: 1" = 10'


BUILDING UNIT K5

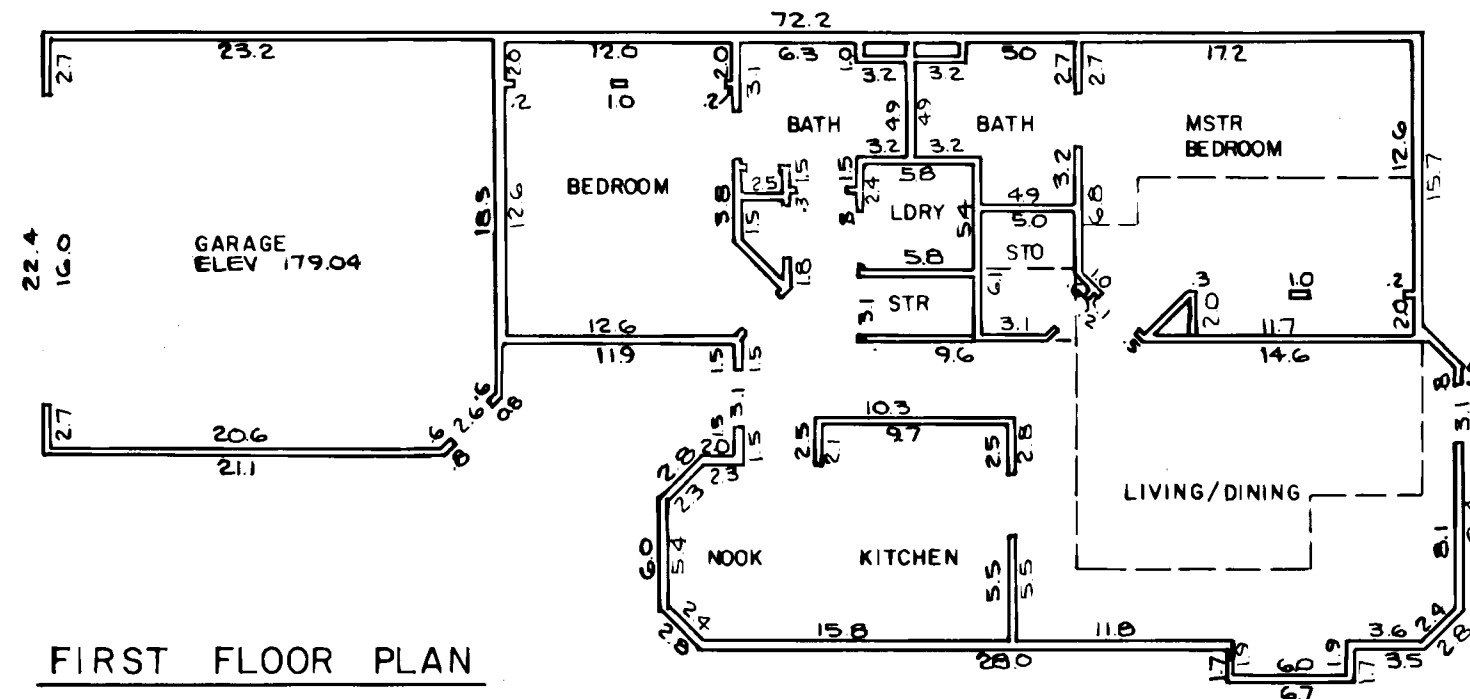


SECOND FLOOR PLAN

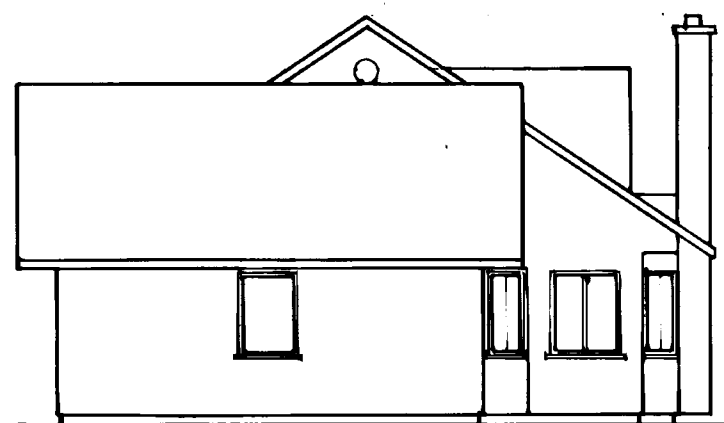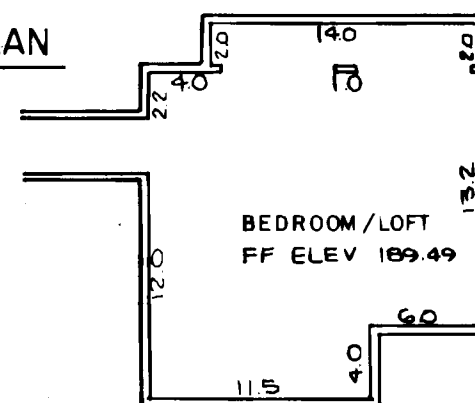


FRONT ELEVATION

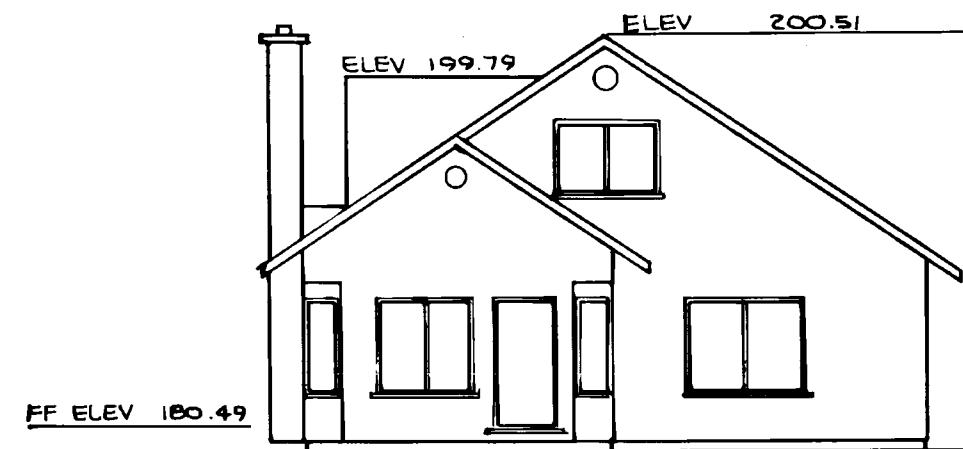

REAR ELEVATION

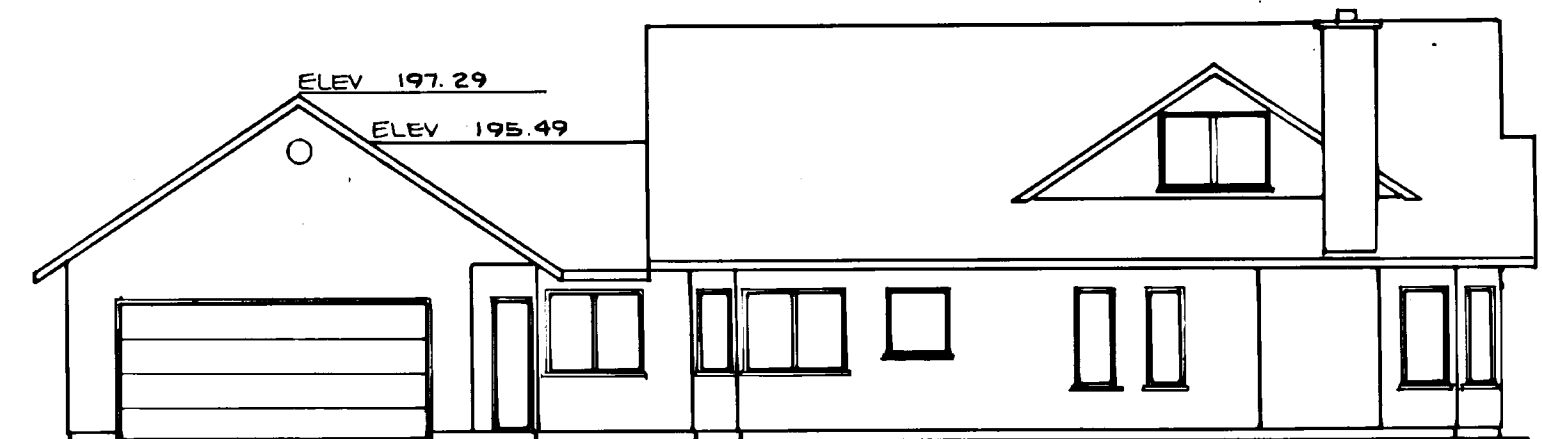

RIGHT ELEVATION

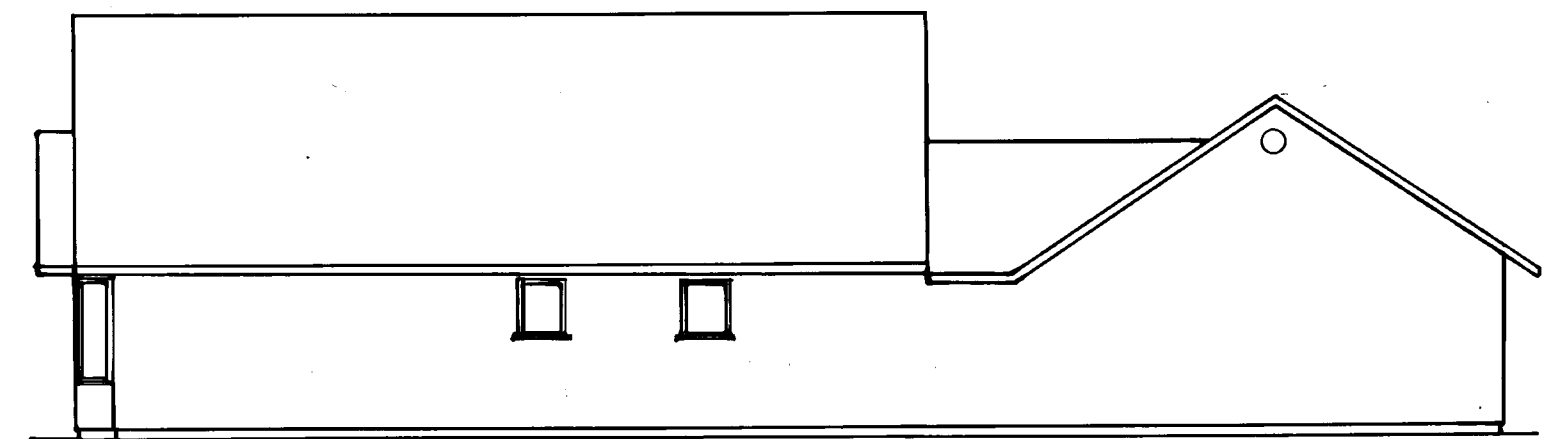

LEFT ELEVATION

901030215

VILLAGE AT CORDATA · NORTH SIDE · PHASE I


A PORTION OF PARCEL 4

"CORDATA SPECIFIC BINDING SITE PLAN NO. 1"

SECTION 12, TOWNSHIP 38 NORTH, RANGE 2 EAST, W.M.

SCALE: 1" = 10'



BUILDING UNIT K6

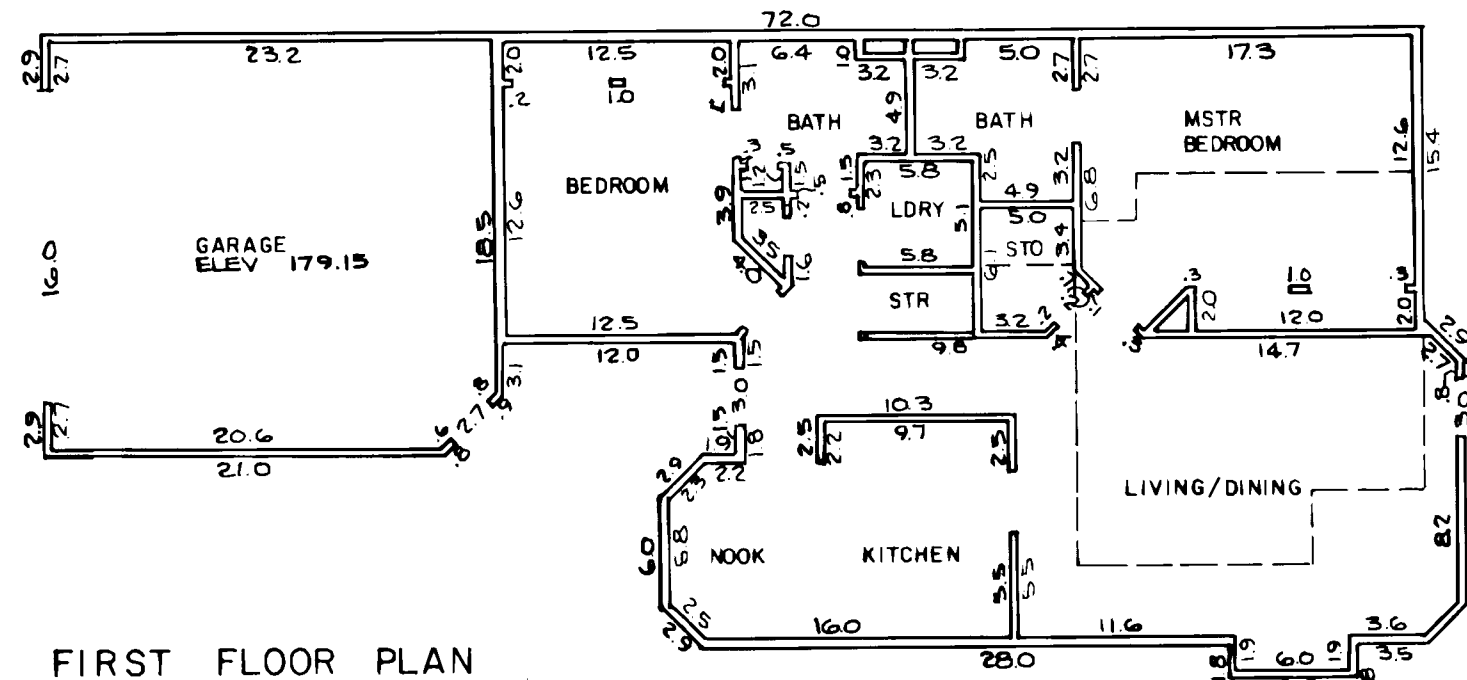


FIRST FLOOR PLAN



SECOND FLOOR PLAN

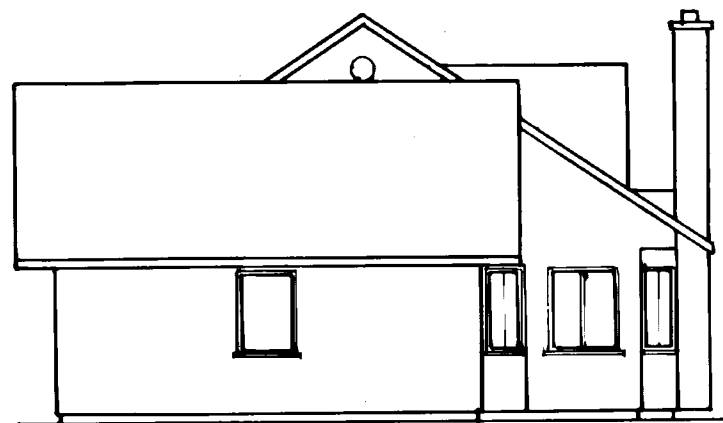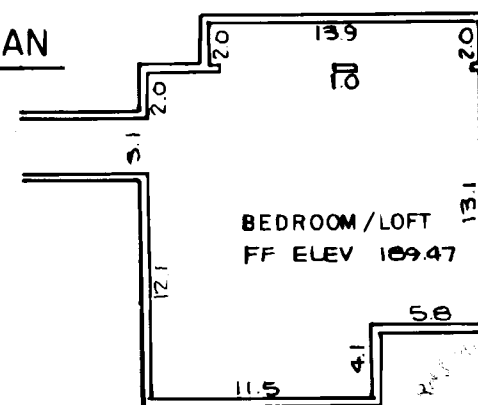


FRONT ELEVATION

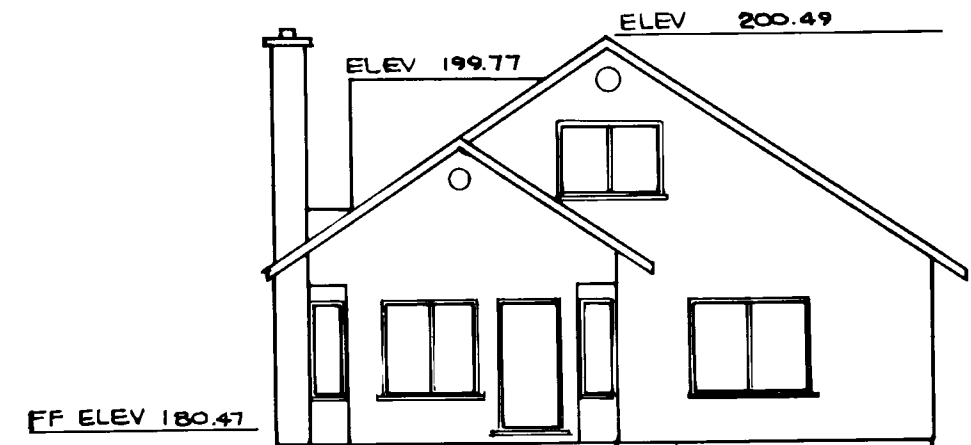

REAR ELEVATION




RIGHT ELEVATION

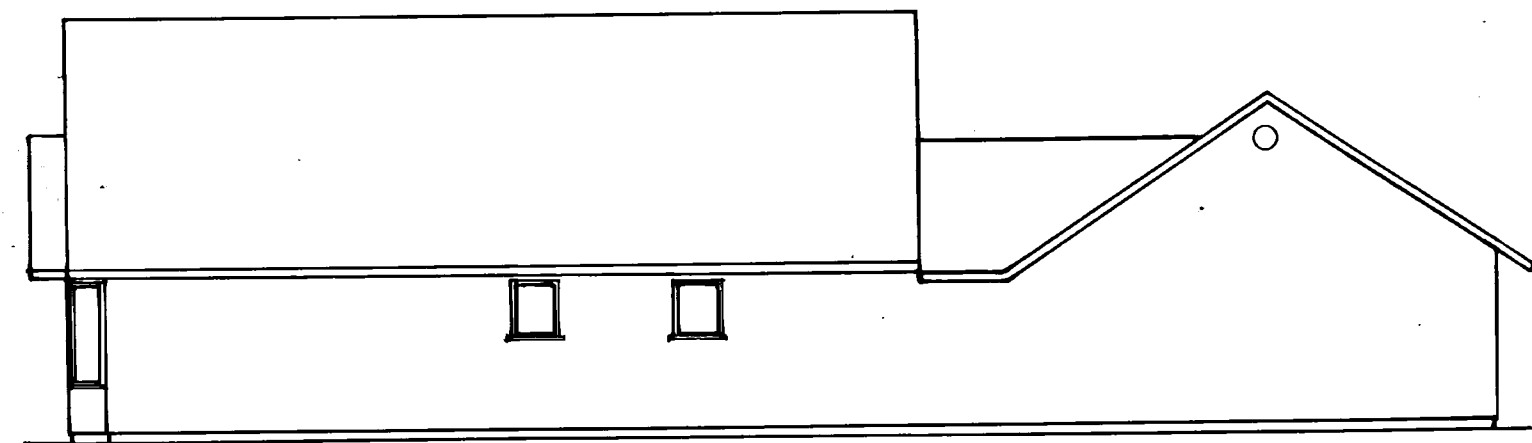


LEFT ELEVATION

A PORTION OF PARCEL 4
"CORDATA SPECIFIC BINDING SITE PLAN NO. 1"
SECTION 12, TOWNSHIP 38 NORTH, RANGE 2 EAST, W.M.
SCALE: 1" = 10'

BUILDING UNIT M7

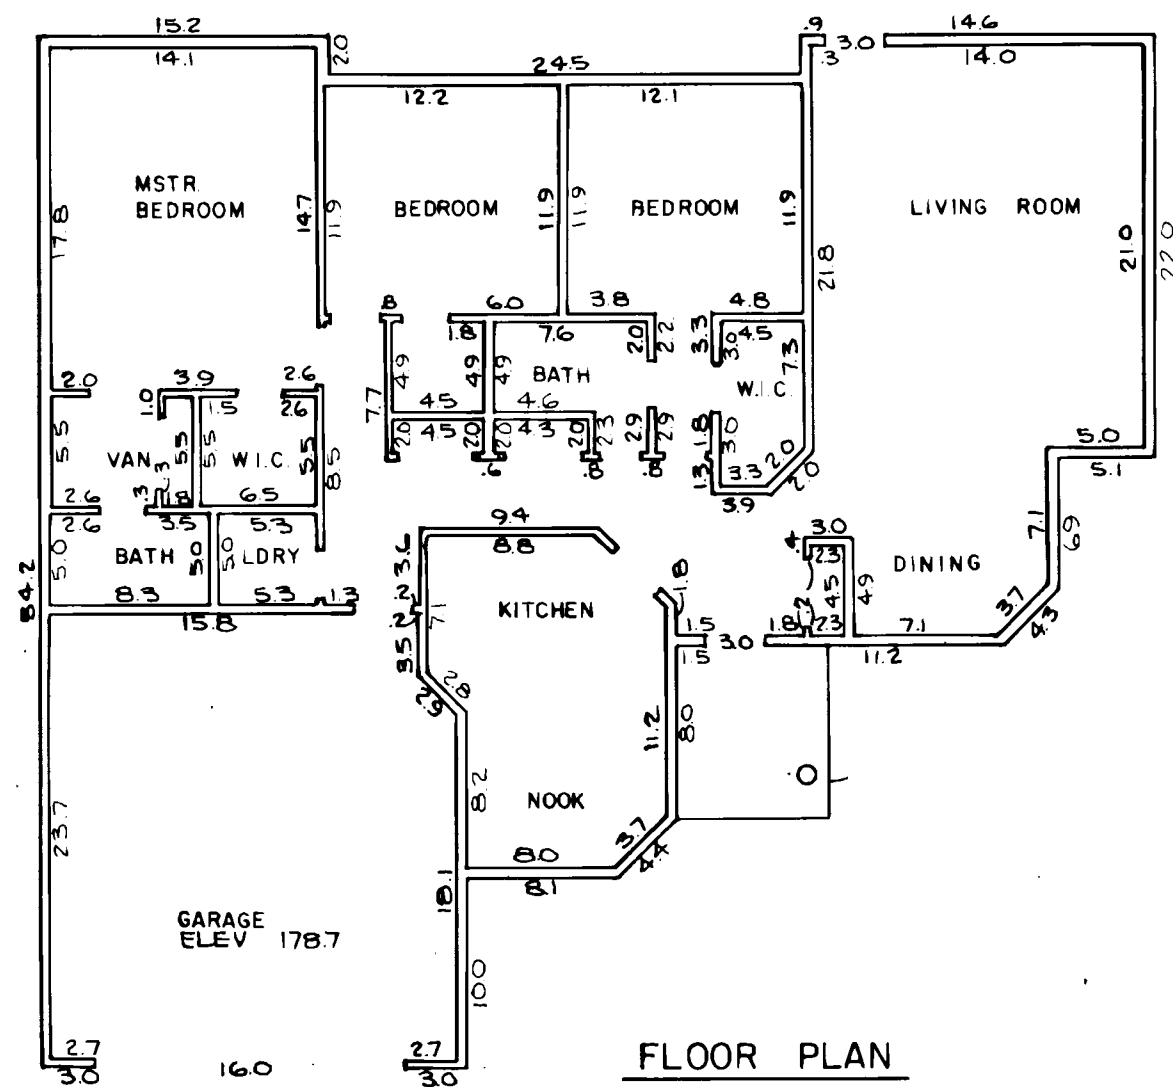


FLOOR PLAN

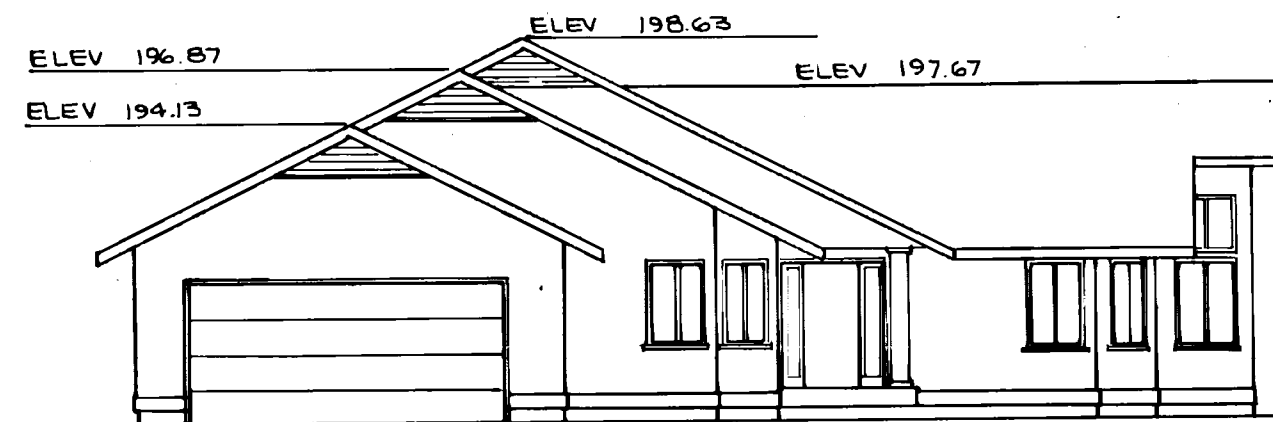


FRONT ELEVATION



REAR ELEVATION

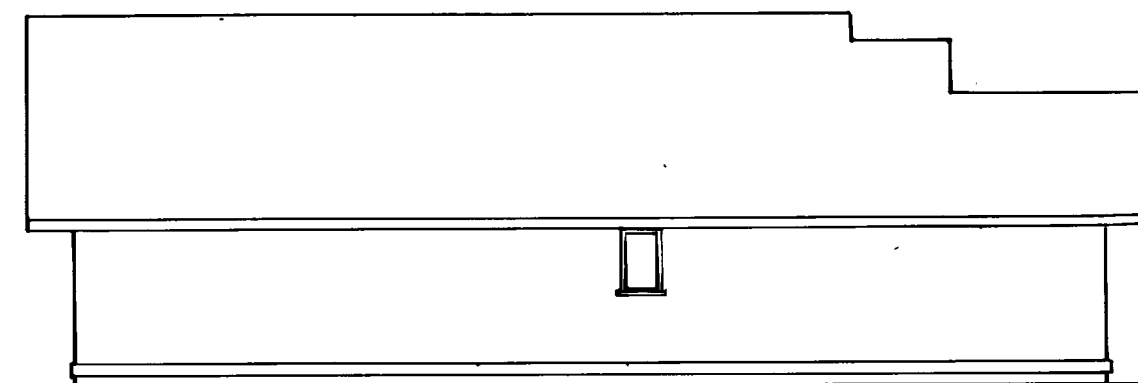

LEFT ELEVATION

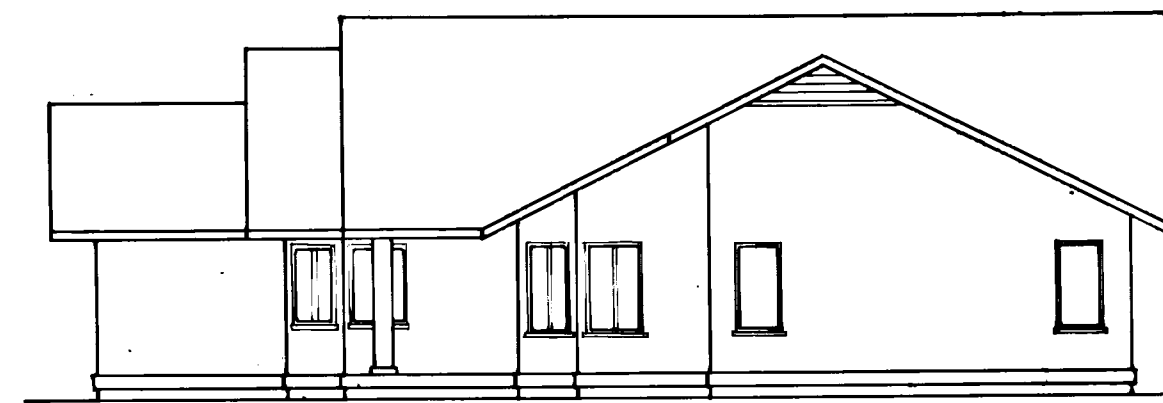

RIGHT ELEVATION

901030215

VILLAGE AT CORDATA NORTH SIDE - PHASE I


A PORTION OF PARCEL 4

"CORDATA SPECIFIC BINDING SITE PLAN NO. 1"


SECTION 12, TOWNSHIP 38 NORTH, RANGE 2 EAST, W.M.

SCALE: 1" = 10'


BUILDING UNIT L8

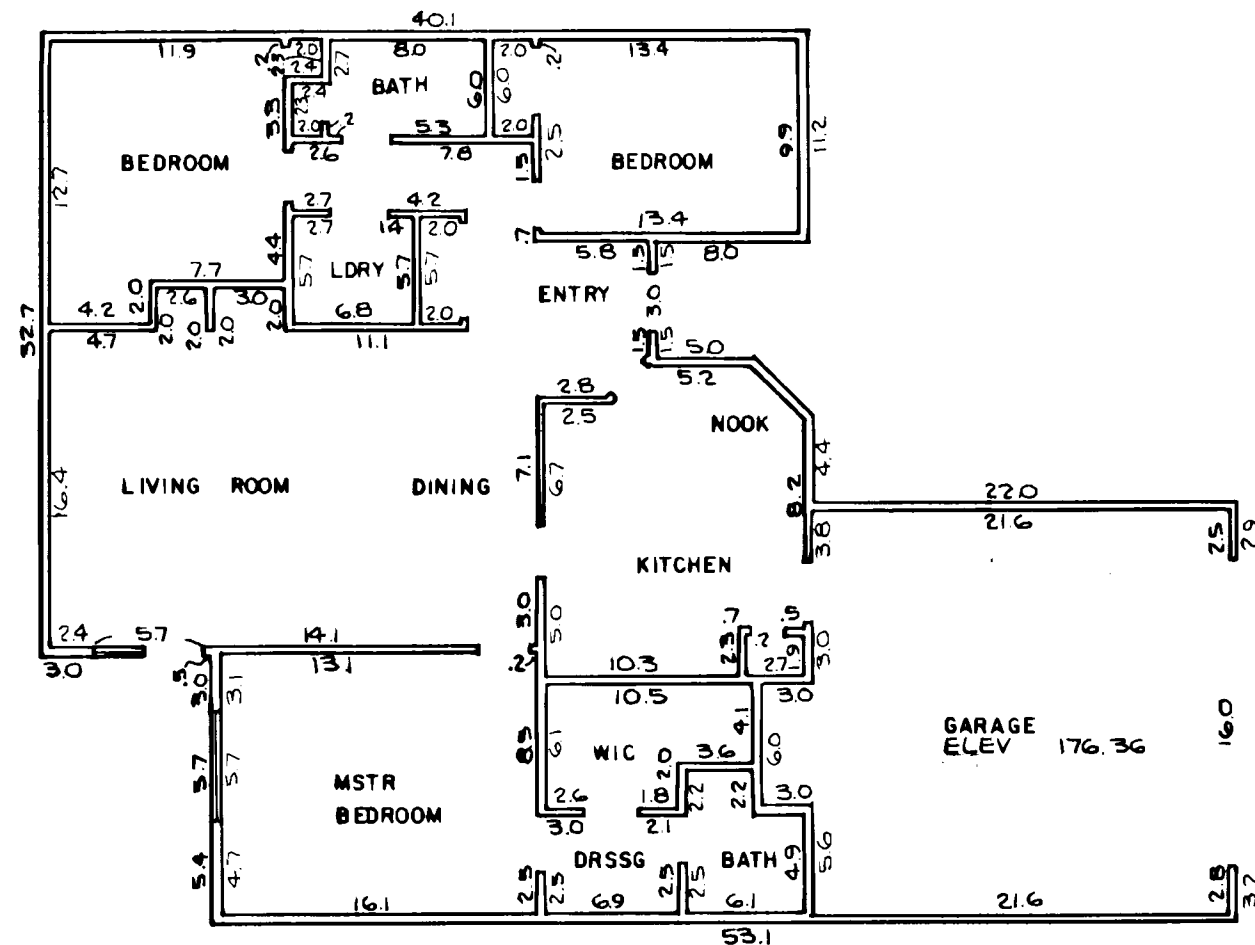


FLOOR PLAN

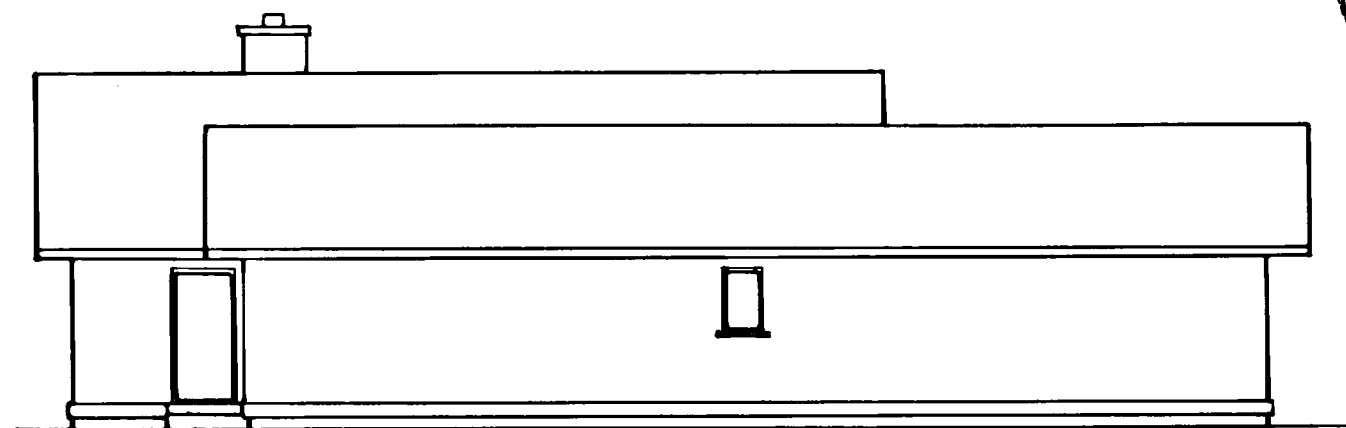


LEFT ELEVATION

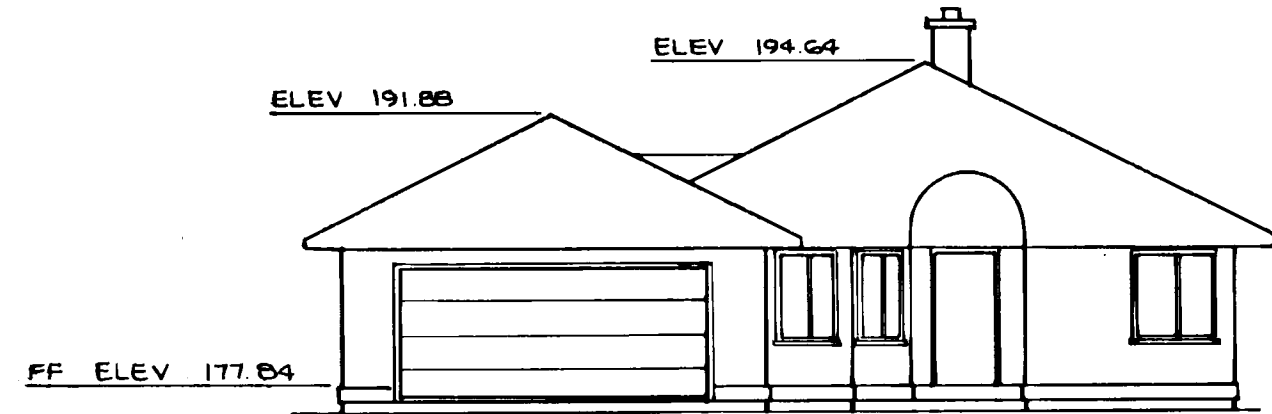

FRONT ELEVATION

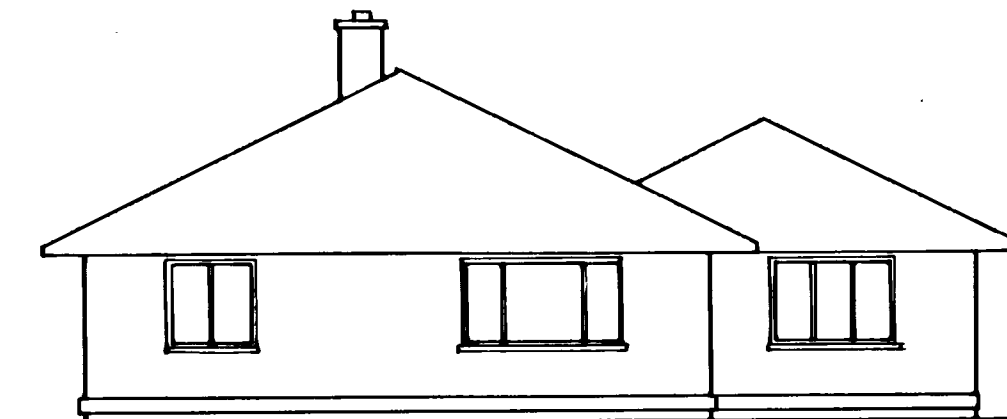

REAR ELEVATION

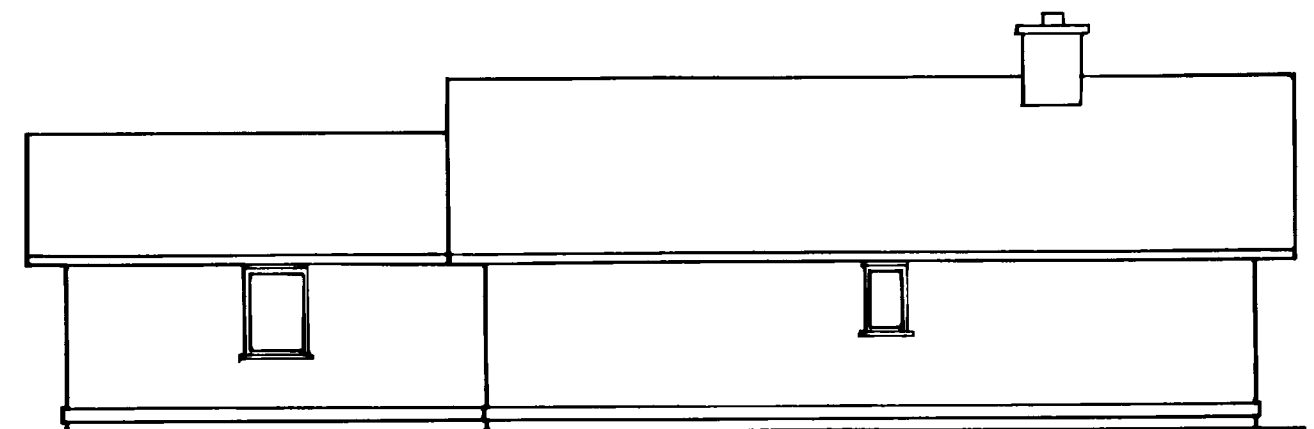


RIGHT ELEVATION

901030215


VILLAGE AT CORDATA · NORTH · SIDE · PHASE I

A PORTION OF PARCEL 4
 "CORDATA SPECIFIC BINDING SITE PLAN NO. 1"
 SECTION 12, TOWNSHIP 38 NORTH, RANGE 2 EAST, W.M.
 SCALE: 1" = 10'


BUILDING UNIT L9

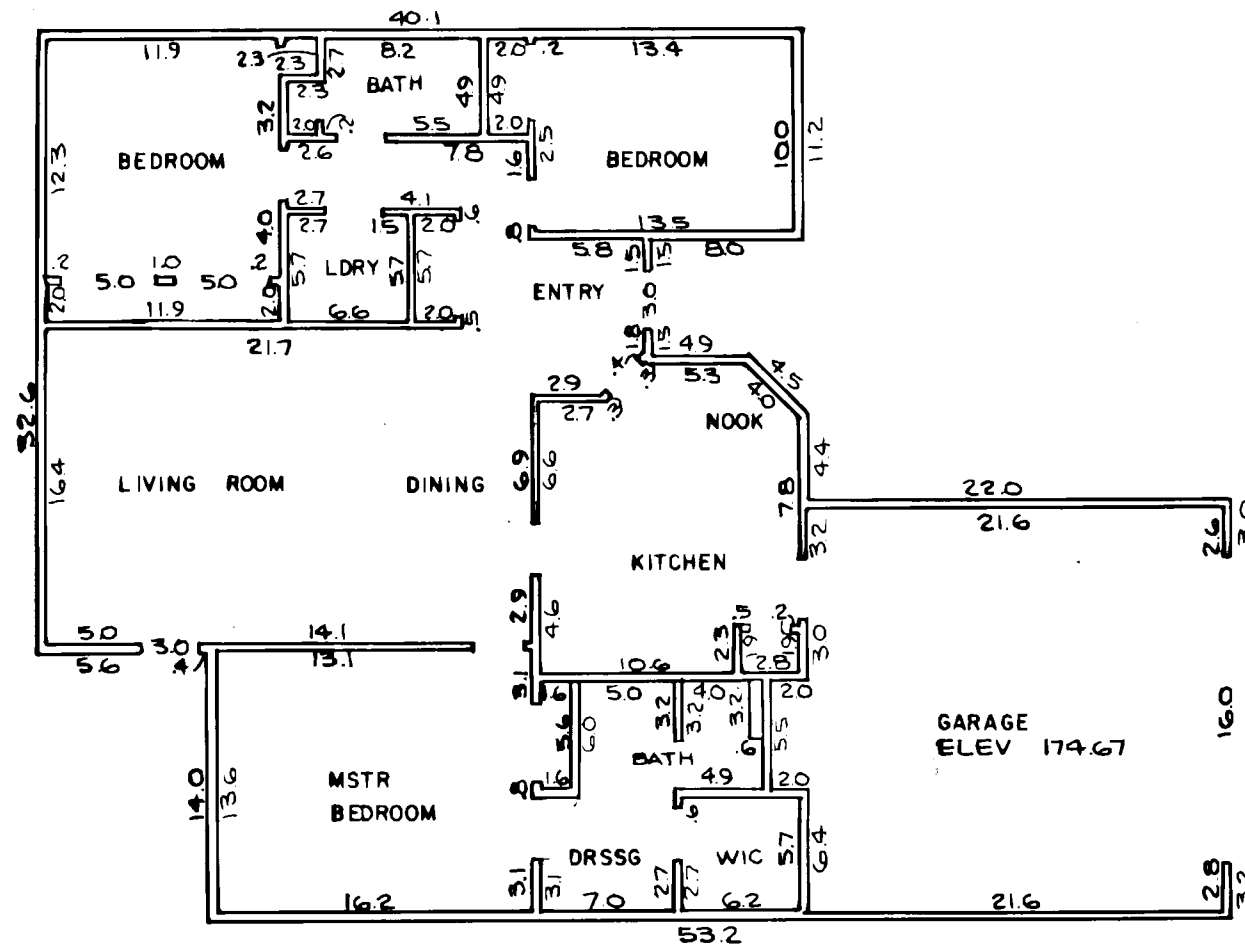


FLOOR PLAN

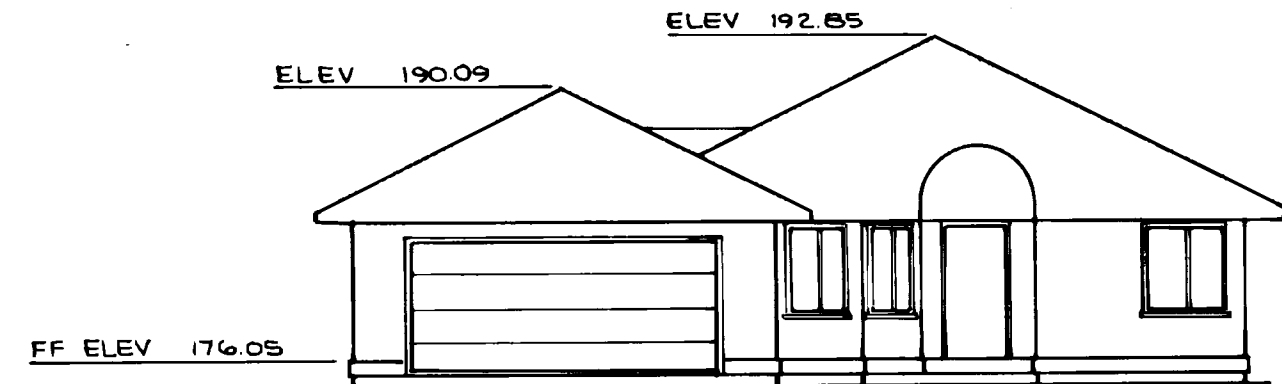


FRONT ELEVATION

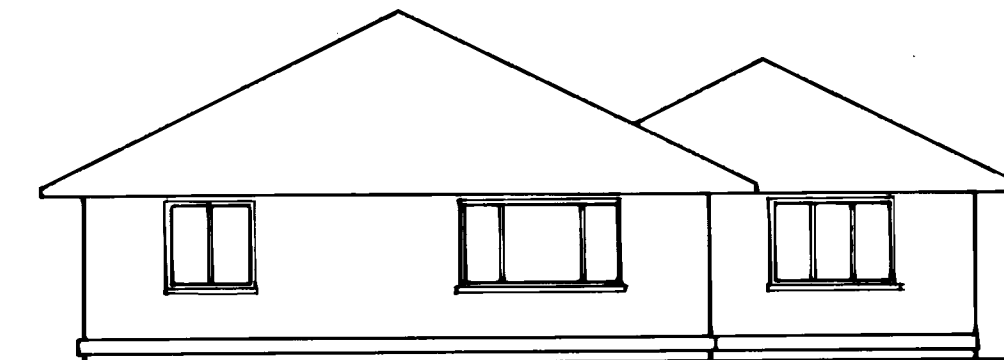

REAR ELEVATION

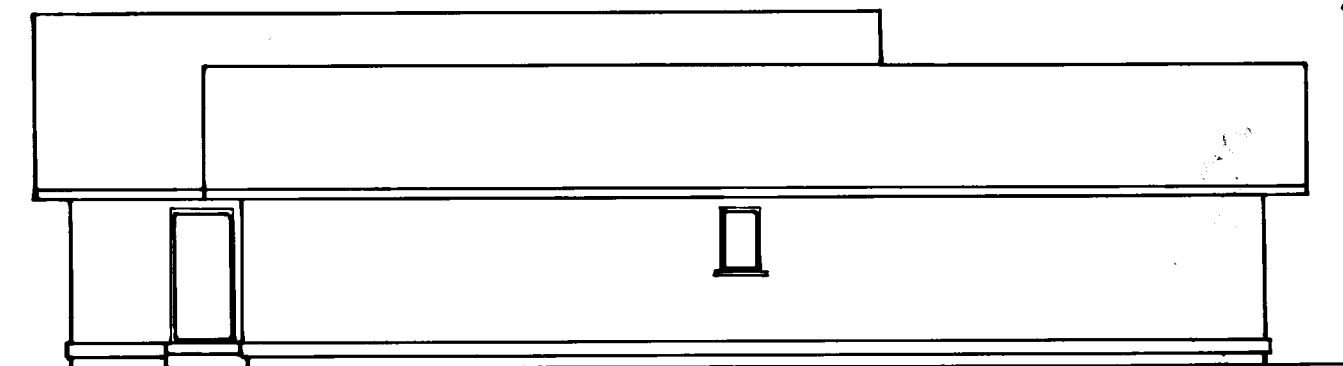

LEFT ELEVATION

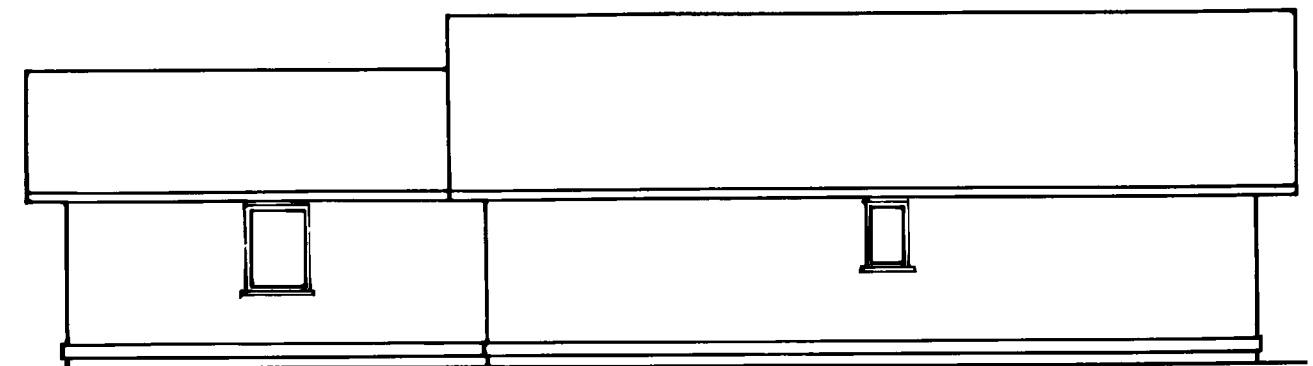

RIGHT ELEVATION



901030215

VILLAGE AT CORDATA · NORTH SIDE · PHASE I


A PORTION OF PARCEL 4

"CORDATA SPECIFIC BINDING SITE PLAN NO. 1"


SECTION 12, TOWNSHIP 38 NORTH, RANGE 2 EAST, W.M.

SCALE: 1" = 10'


BUILDING UNIT G10

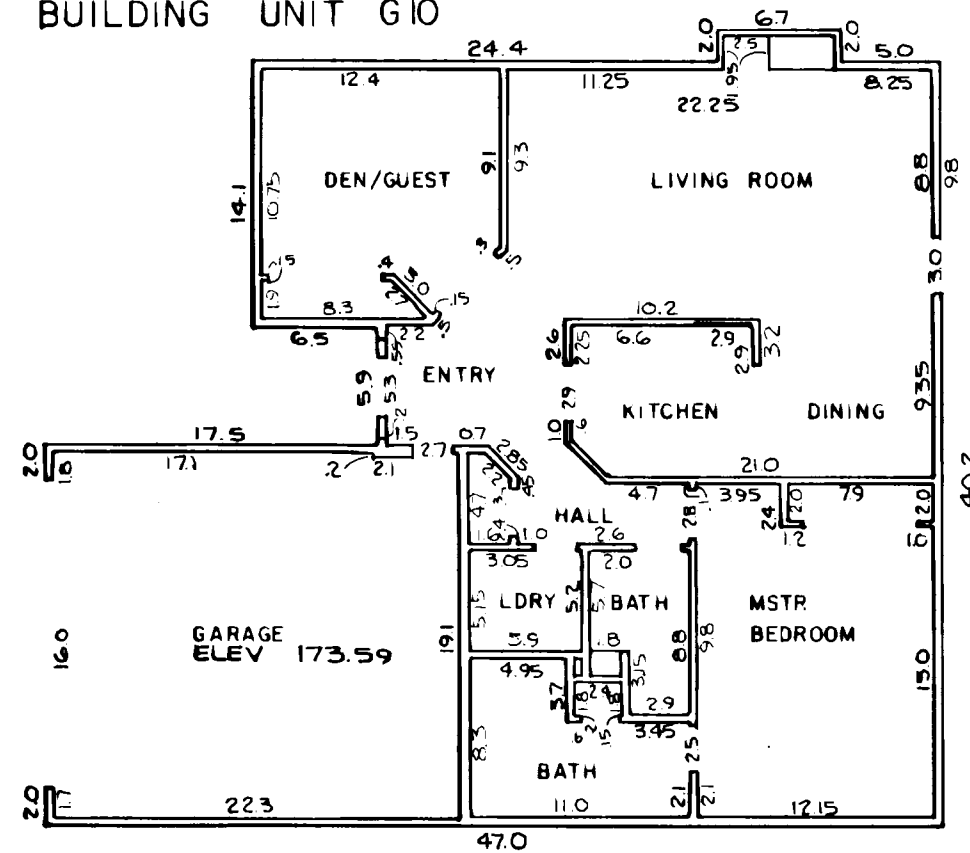


FLOOR PLAN

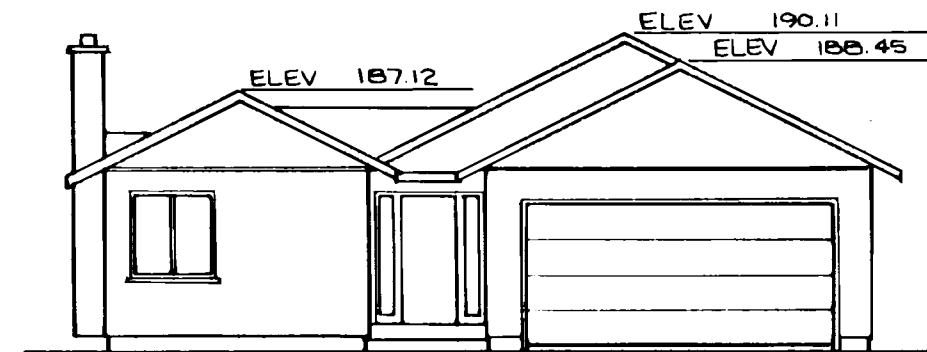


FRONT ELEVATION

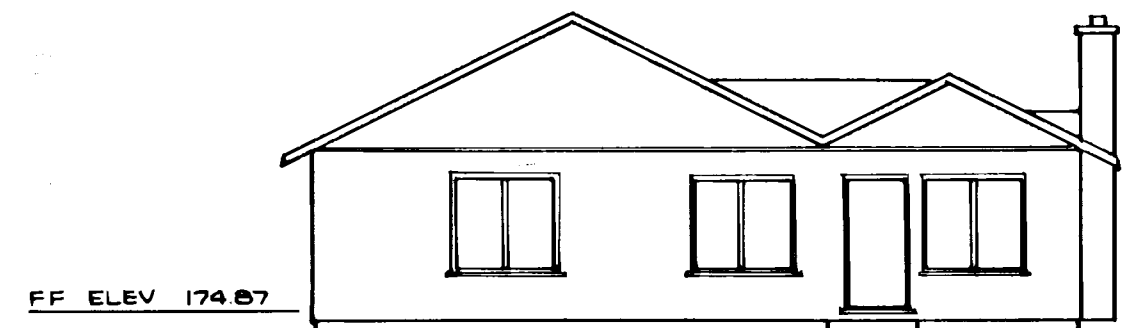

REAR ELEVATION

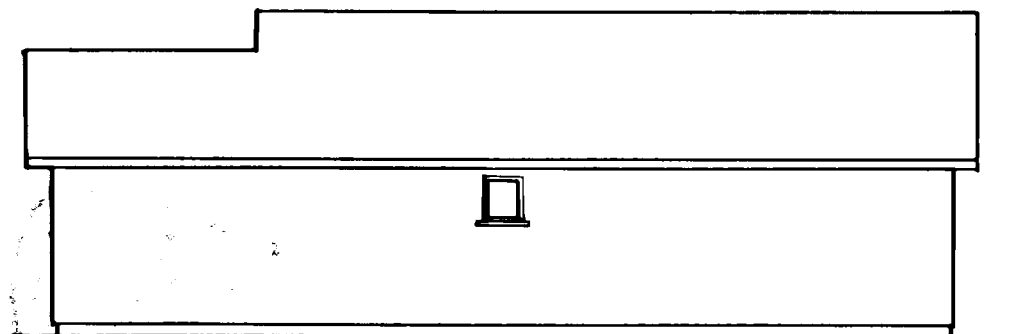

RIGHT ELEVATION

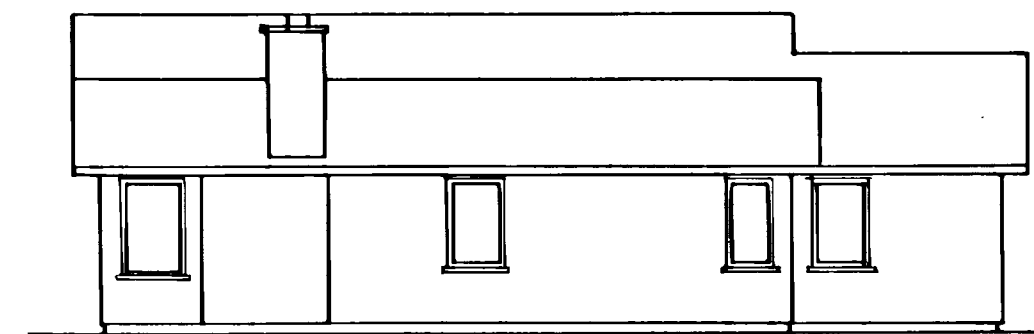

LEFT ELEVATION

901030215

VILLAGE AT CORDATA · NORTH SIDE · PHASE I


A PORTION OF PARCEL 4

"CORDATA SPECIFIC BINDING SITE PLAN NO. 1"

SECTION 12, TOWNSHIP 38 NORTH, RANGE 2 EAST, W.M.

SCALE: 1" = 10'


BUILDING UNIT H II

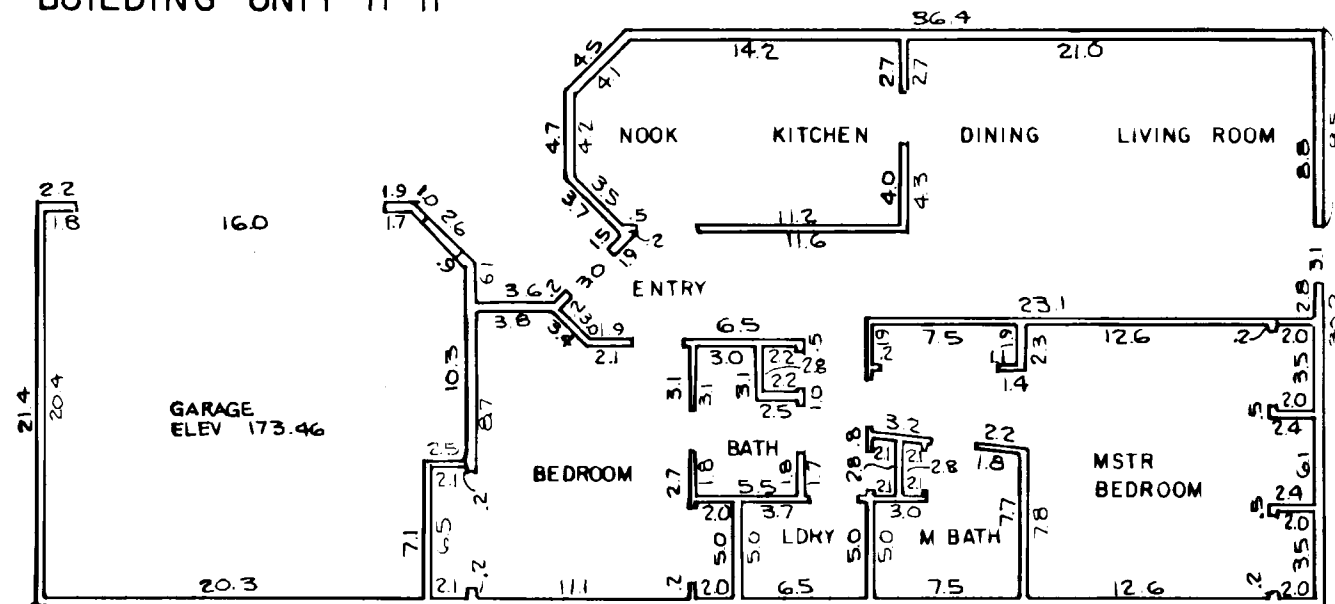


FLOOR PLAN




FRONT ELEVATION

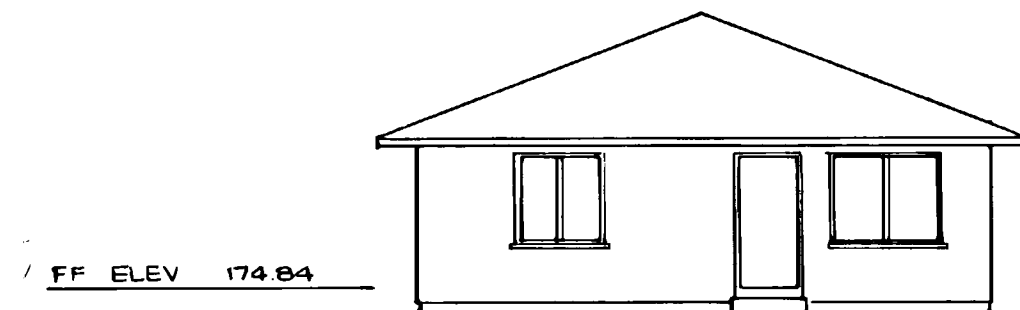

REAR ELEVATION

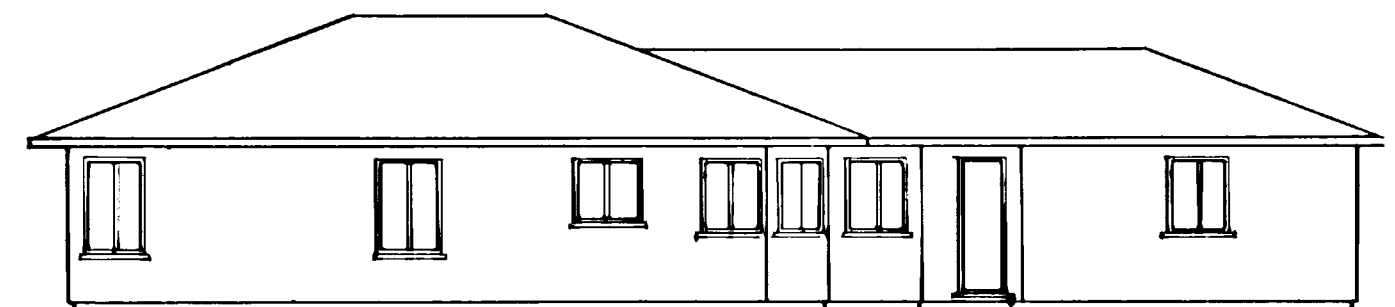

LEFT ELEVATION

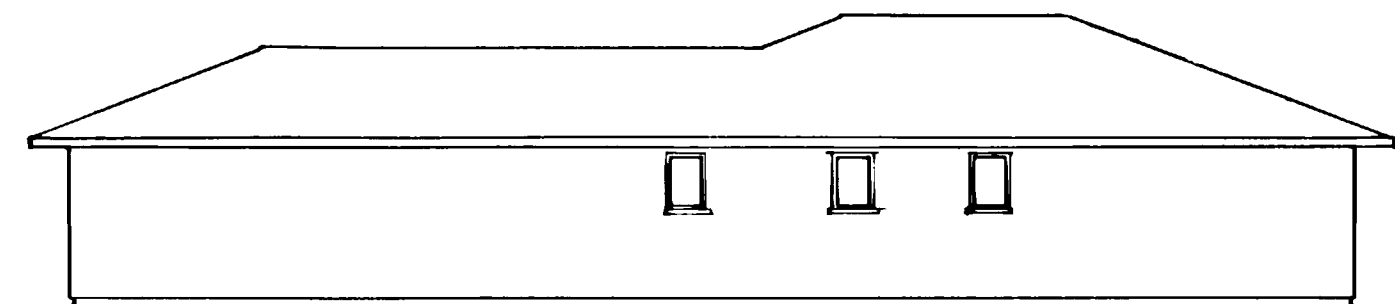

RIGHT ELEVATION



901030215

VILLAGE AT CORDATA · NORTH SIDE · PHASE I


A PORTION OF PARCEL 4

"CORDATA SPECIFIC BINDING SITE PLAN NO. 1"


SECTION 12, TOWNSHIP 38 NORTH, RANGE 2 EAST, W.M.

SCALE: 1" = 10'

BUILDING UNIT J12

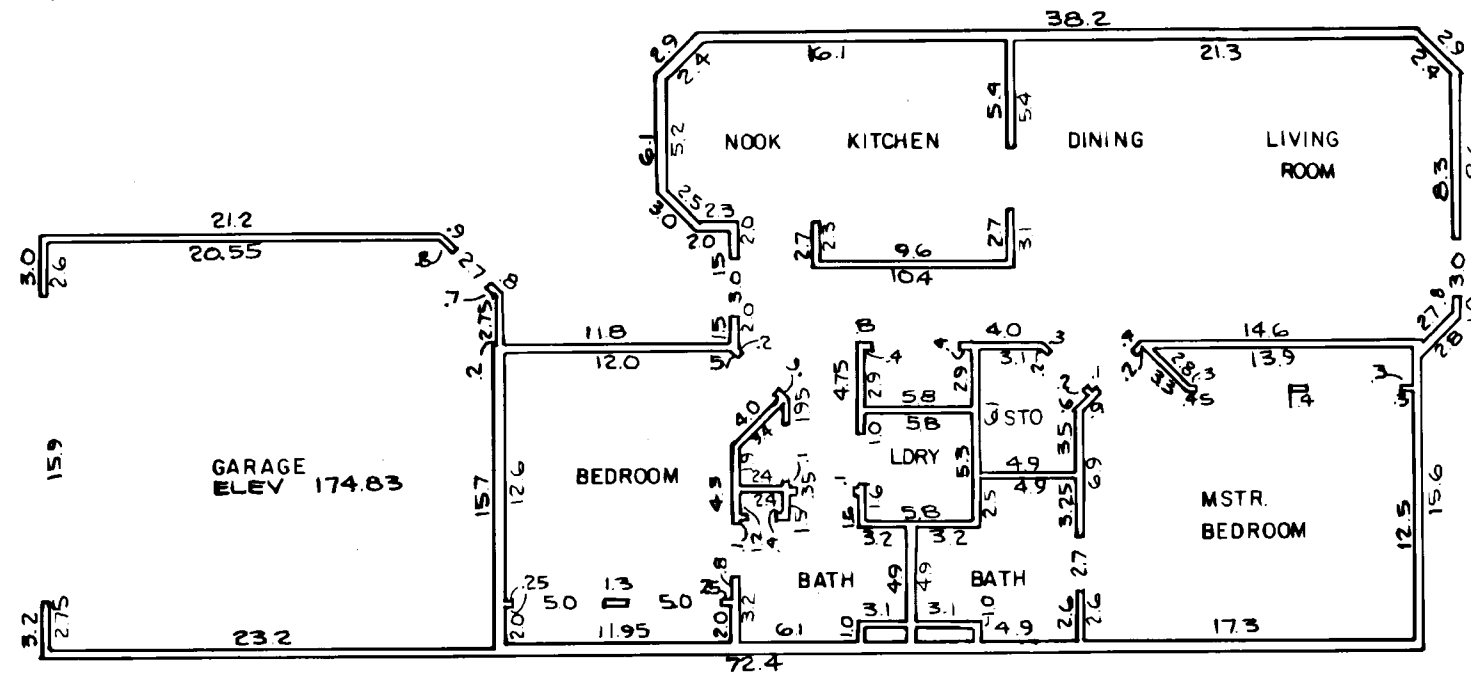


FLOOR PLAN

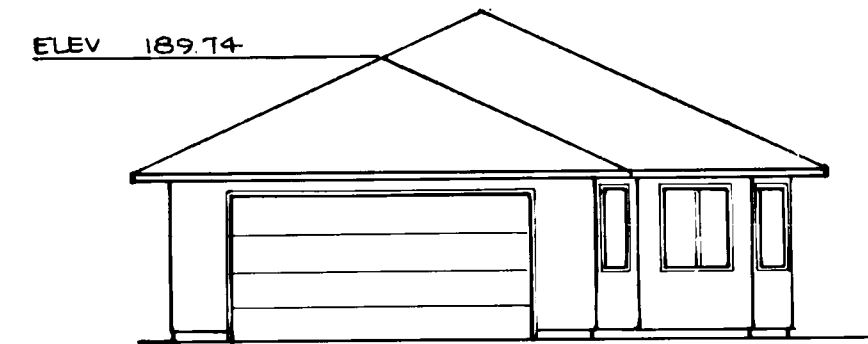

FRONT ELEVATION



REAR ELEVATION

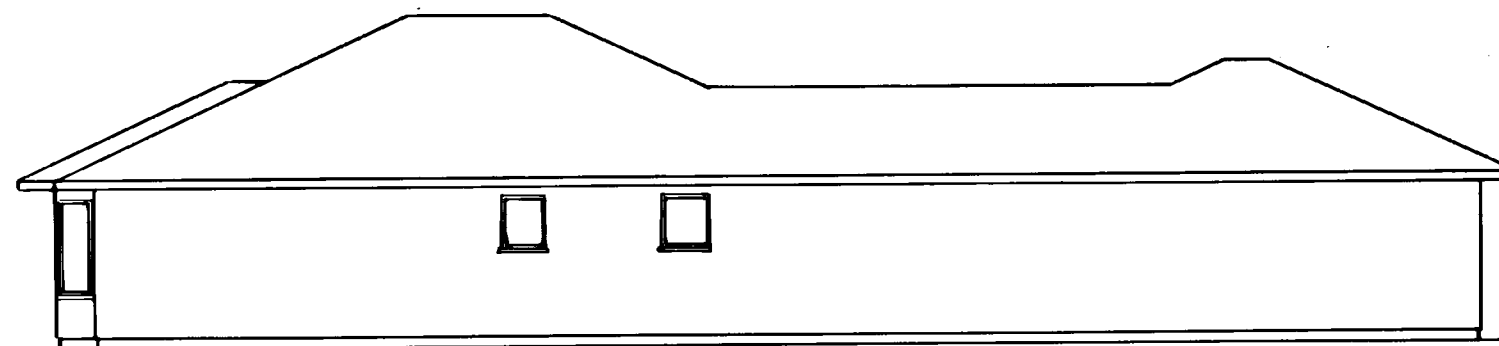

RIGHT ELEVATION



LEFT ELEVATION

901030215

VILLAGE AT CORDATA · NORTH SIDE · PHASE I


A PORTION OF PARCEL 4

"CORDATA SPECIFIC BINDING SITE PLAN NO. 1"


SECTION 12, TOWNSHIP 38 NORTH, RANGE 2 EAST, W.M.

SCALE: 1" = 10'

BUILDING UNIT J13

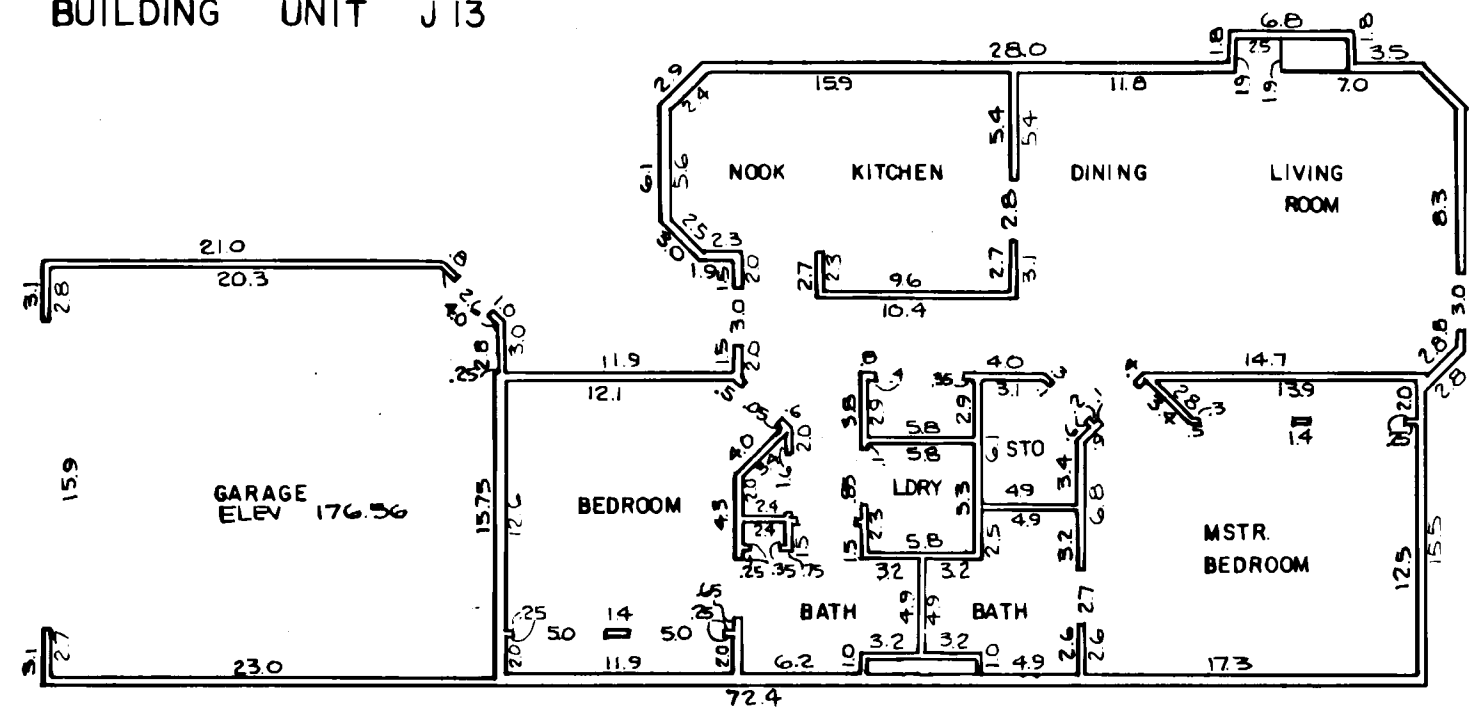


FLOOR PLAN

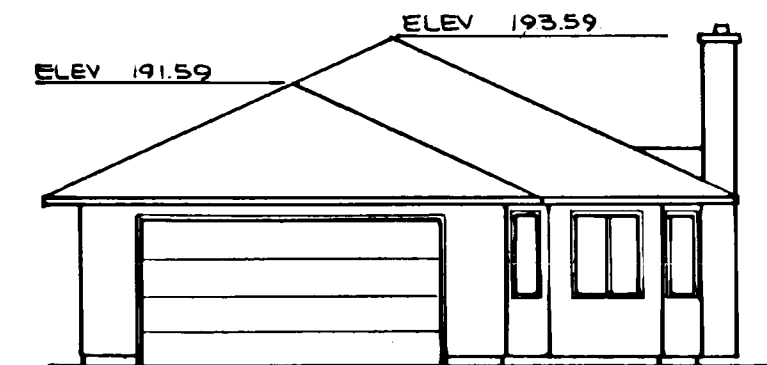

FRONT ELEVATION



REAR ELEVATION

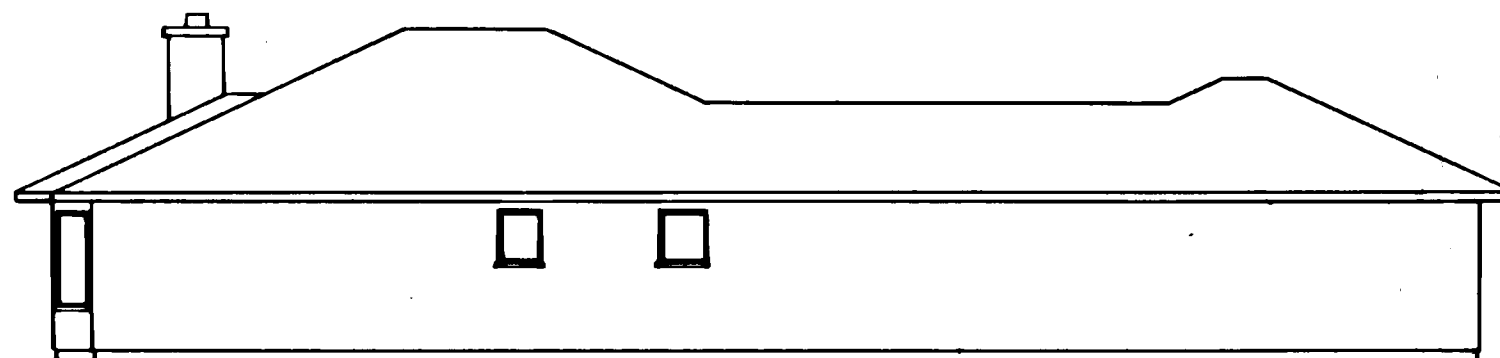

RIGHT ELEVATION



LEFT ELEVATION



901030215

VILLAGE AT CORDATA · NORTH SIDE · PHASE I


A PORTION OF PARCEL 4

"CORDATA SPECIFIC BINDING SITE PLAN NO. 1"


SECTION 12, TOWNSHIP 38 NORTH, RANGE 2 EAST, W.M.

SCALE: 1" = 10'


BUILDING UNIT - M 14

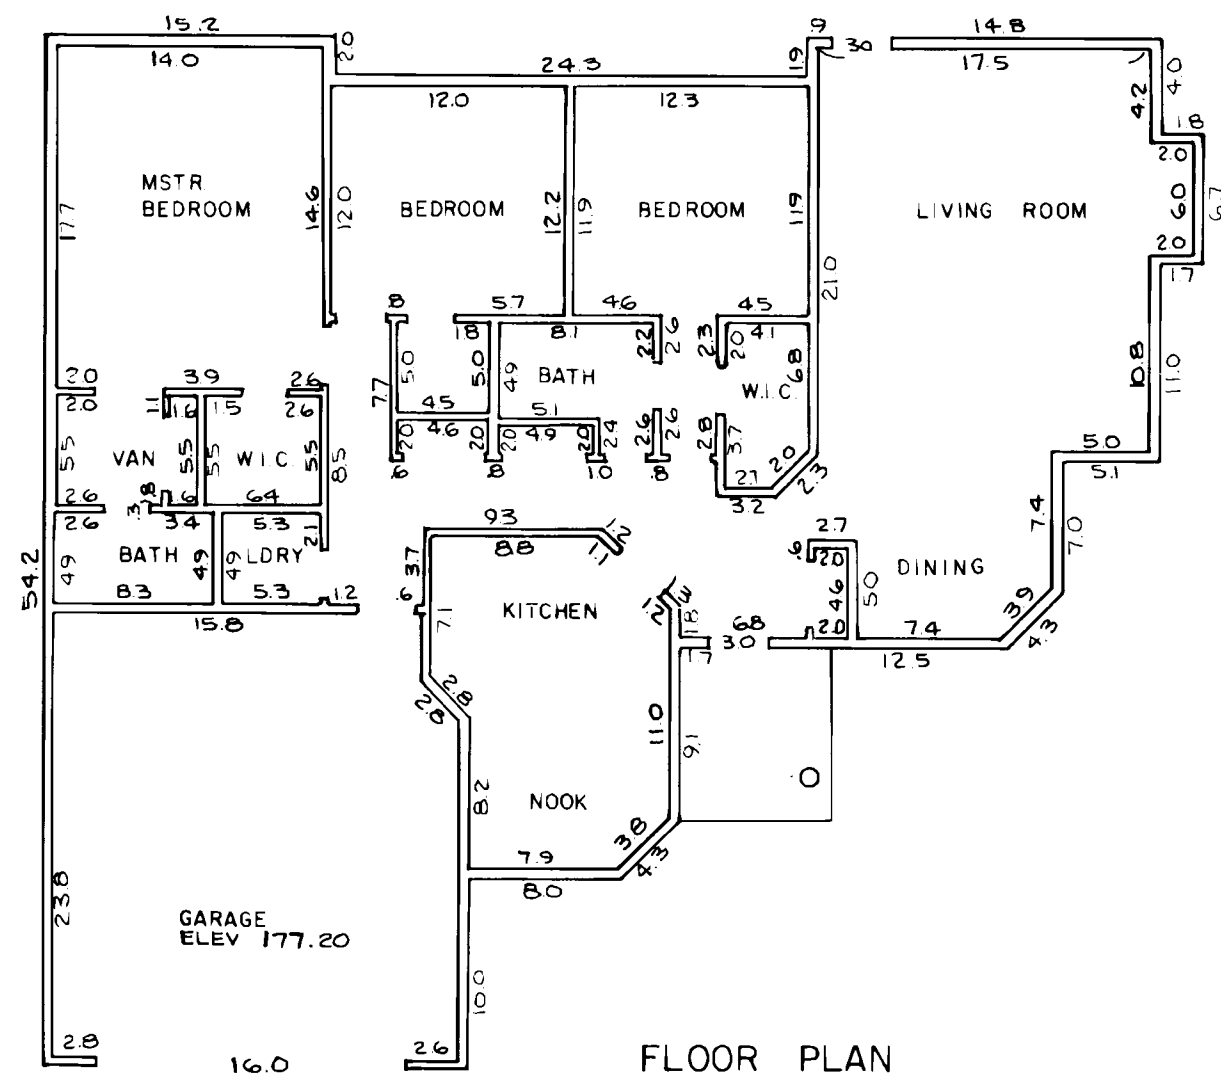


FLOOR PLAN

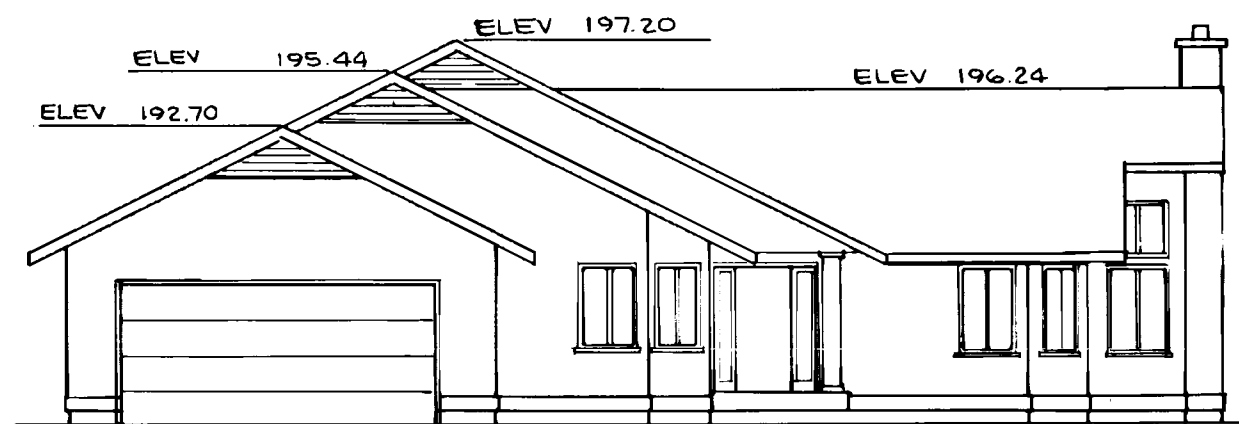


FRONT ELEVATION

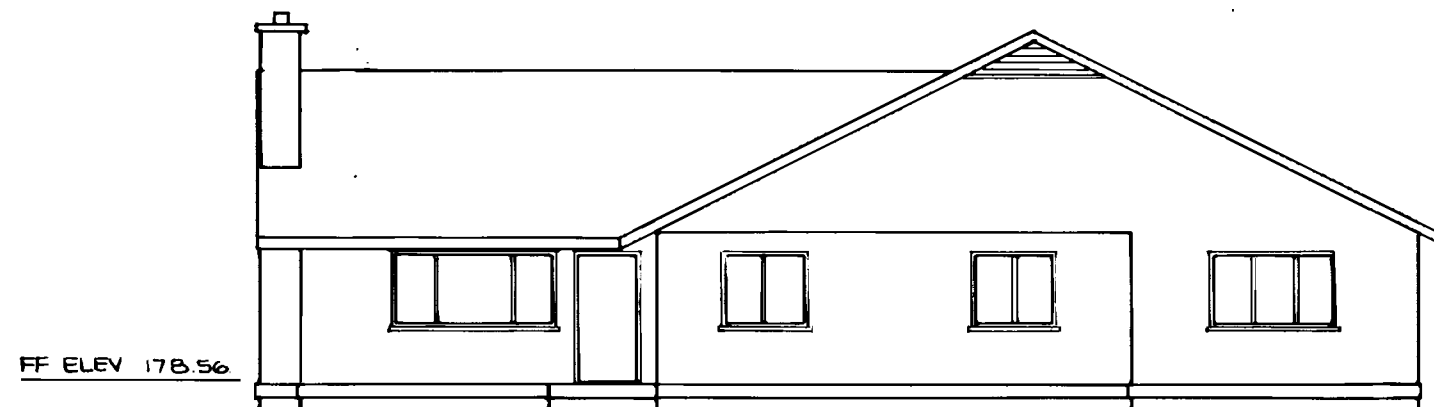

REAR ELEVATION

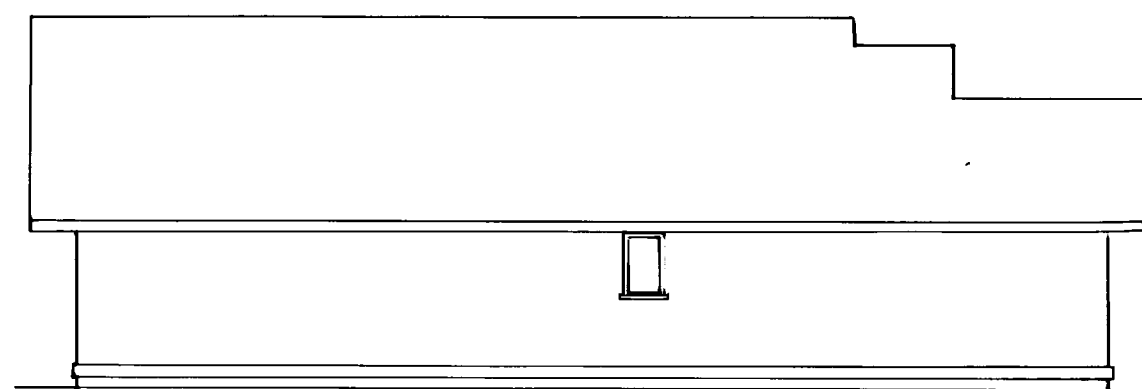

LEFT ELEVATION

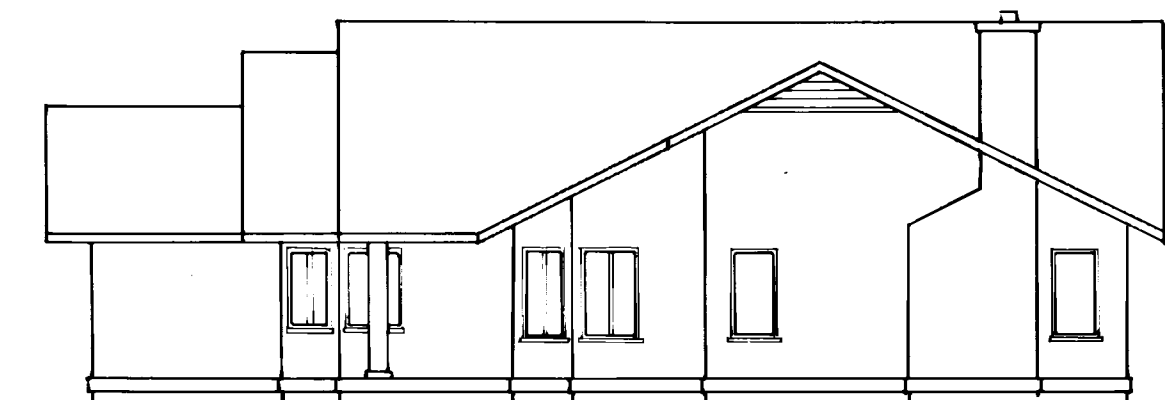


RIGHT ELEVATION

901030215


VILLAGE AT CORDATA · NORTH SIDE · PHASE I

A PORTION OF PARCEL 4
 "CORDATA SPECIFIC BINDING SITE PLAN NO. 1"
 SECTION 12, TOWNSHIP 38 NORTH, RANGE 2 EAST, W.M.
 SCALE: 1" = 10'


BUILDING UNIT H15

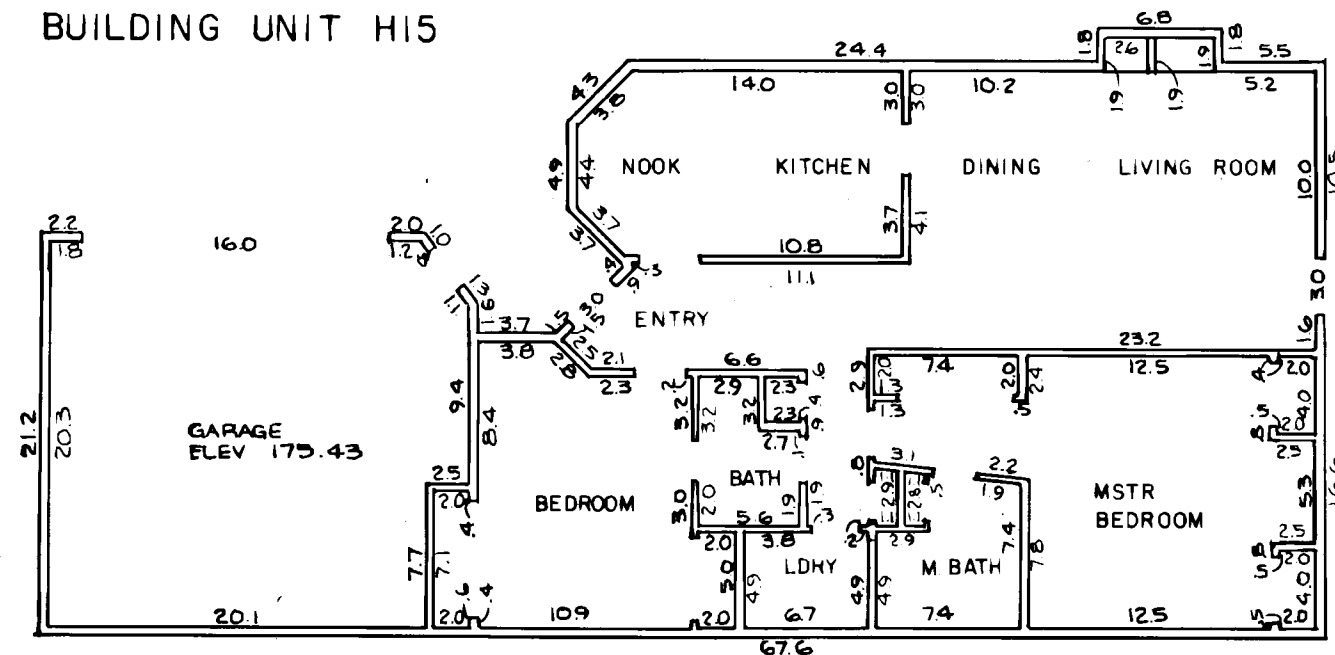

FLOOR PLAN

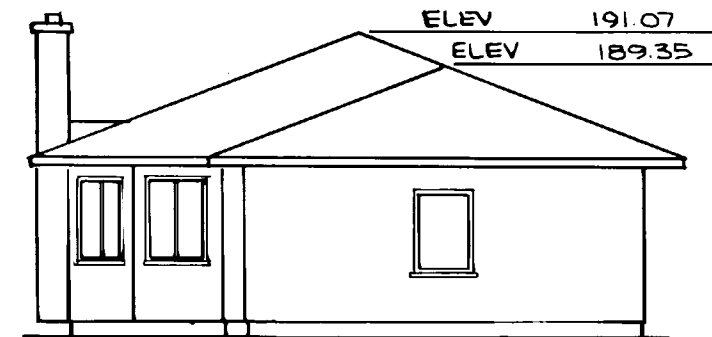


FRONT ELEVATION

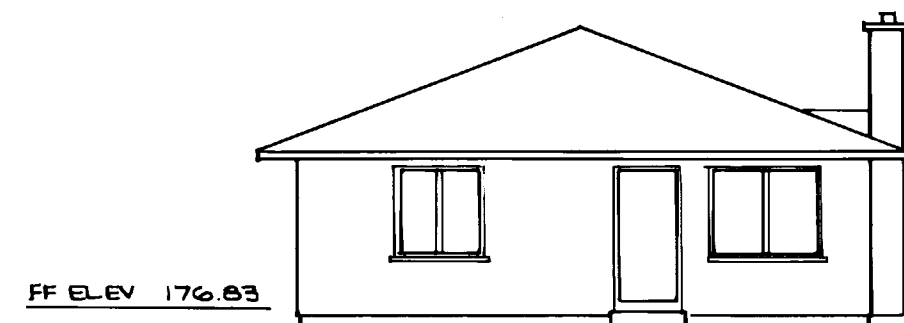

REAR ELEVATION



LEFT ELEVATION

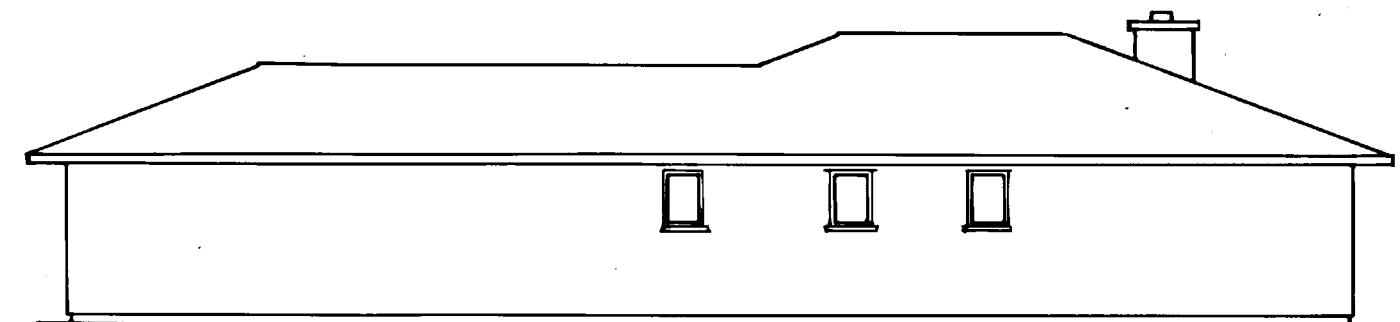

RIGHT ELEVATION



901030215

VILLAGE AT CORDATA · NORTH SIDE · PHASE I


A PORTION OF PARCEL 4

"CORDATA SPECIFIC BINDING SITE PLAN NO. 1"


SECTION 12, TOWNSHIP 38 NORTH, RANGE 2 EAST, W.M.

SCALE: 1"=10'


BUILDING UNIT G16

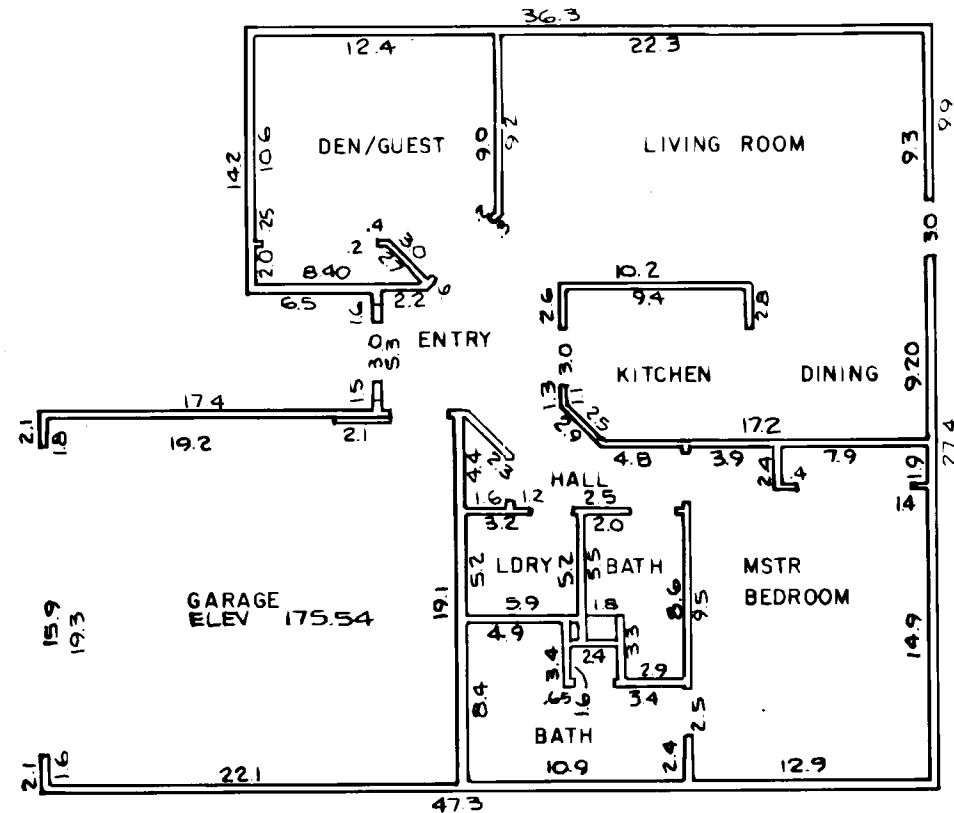


FLOOR PLAN

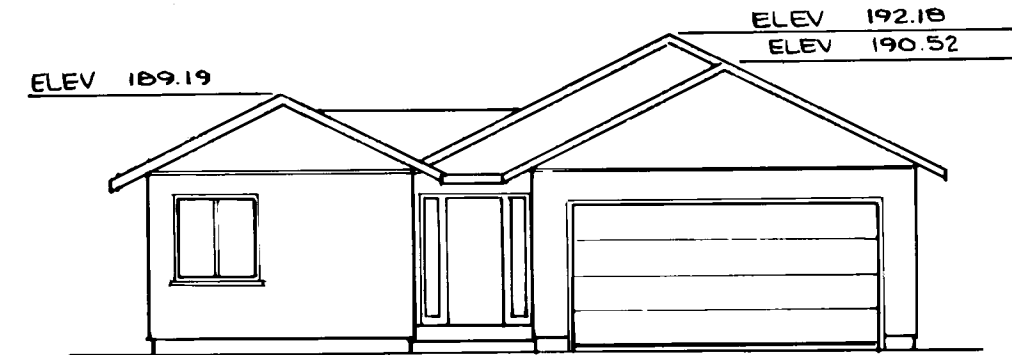


FRONT ELEVATION

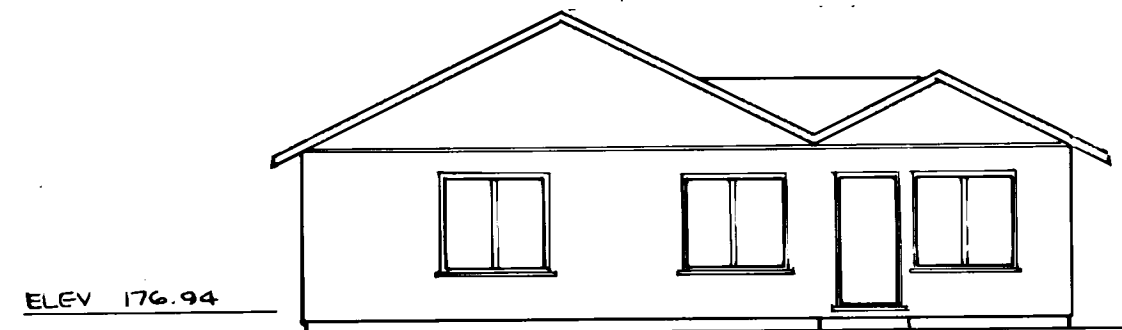

REAR ELEVATION

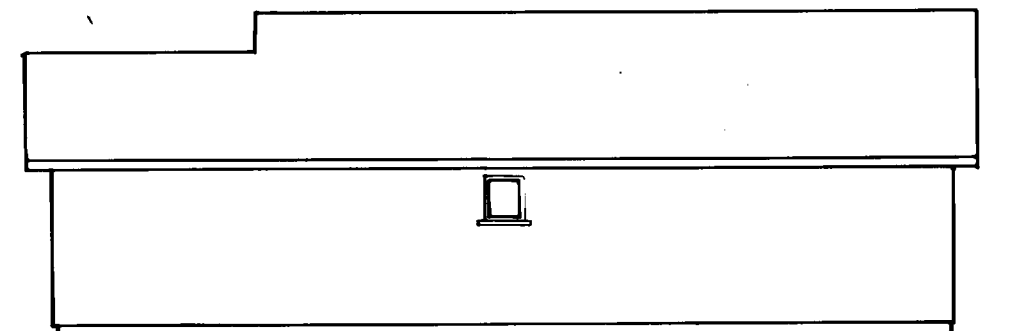

RIGHT ELEVATION

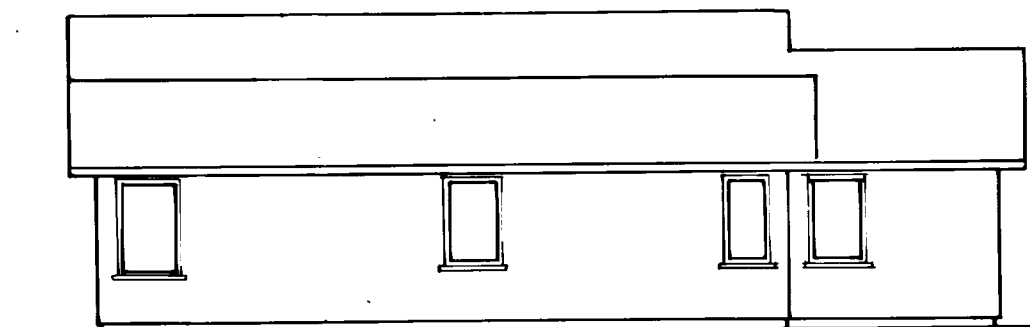

LEFT ELEVATION

901030215

VILLAGE AT CORDATA · NORTH SIDE · PHASE I


A PORTION OF PARCEL 4

"CORDATA SPECIFIC BINDING SITE PLAN NO. 1"


SECTION 12, TOWNSHIP 38 NORTH, RANGE 2 EAST, W.M.

SCALE: 1" = 10'


BUILDING UNIT M17

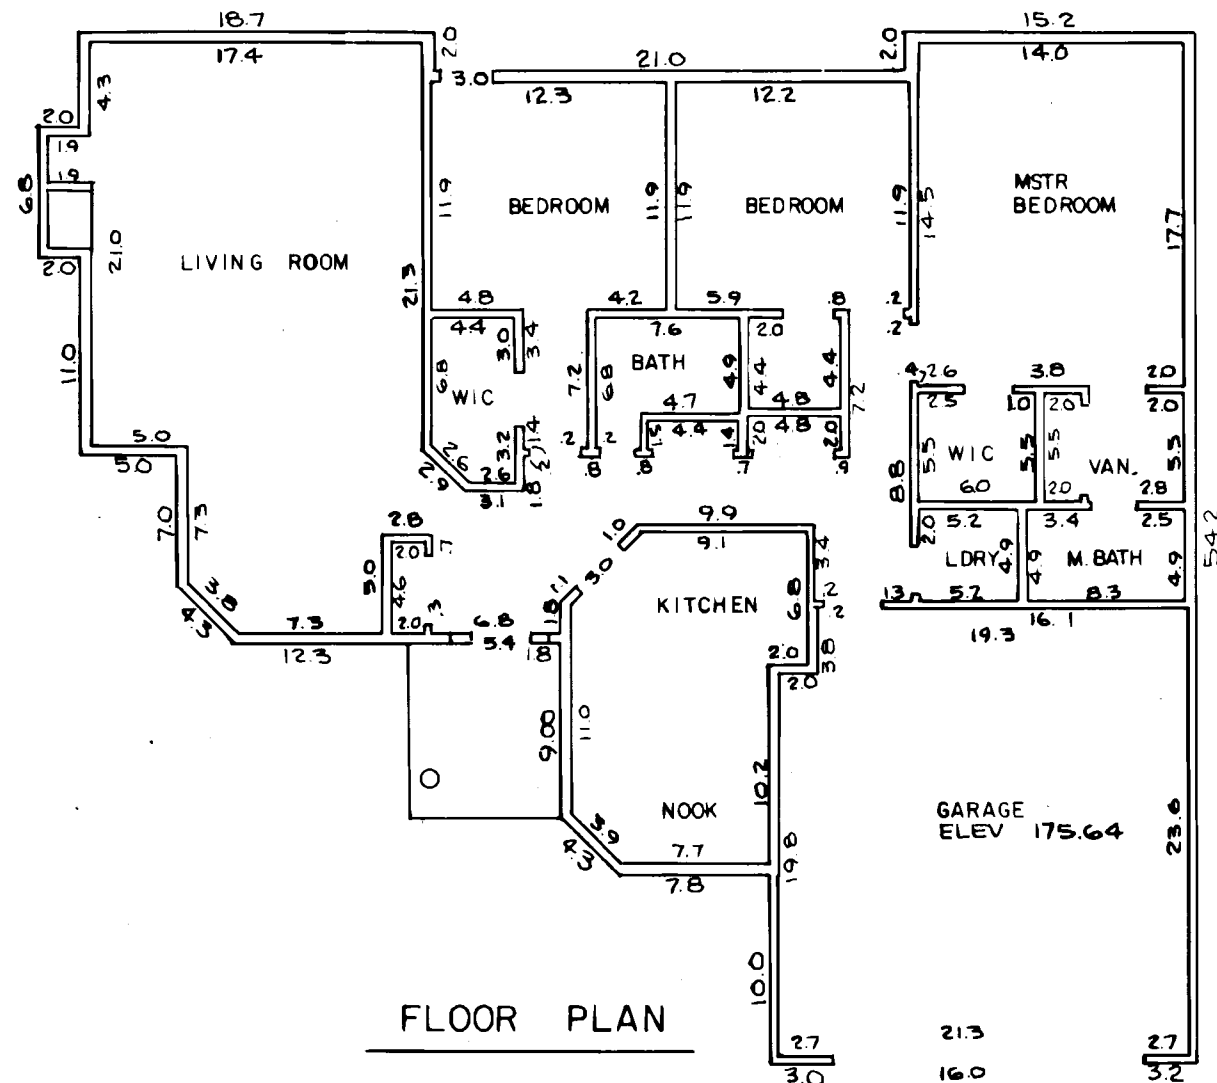


FLOOR PLAN

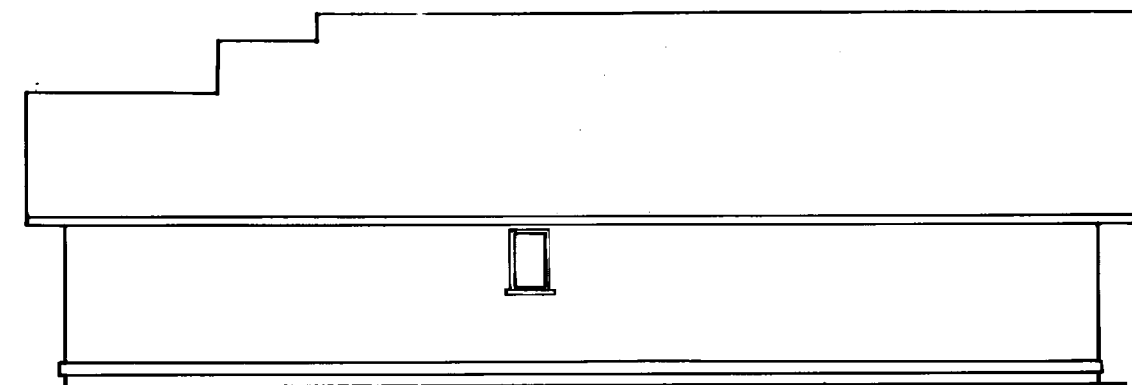


RIGHT ELEVATION

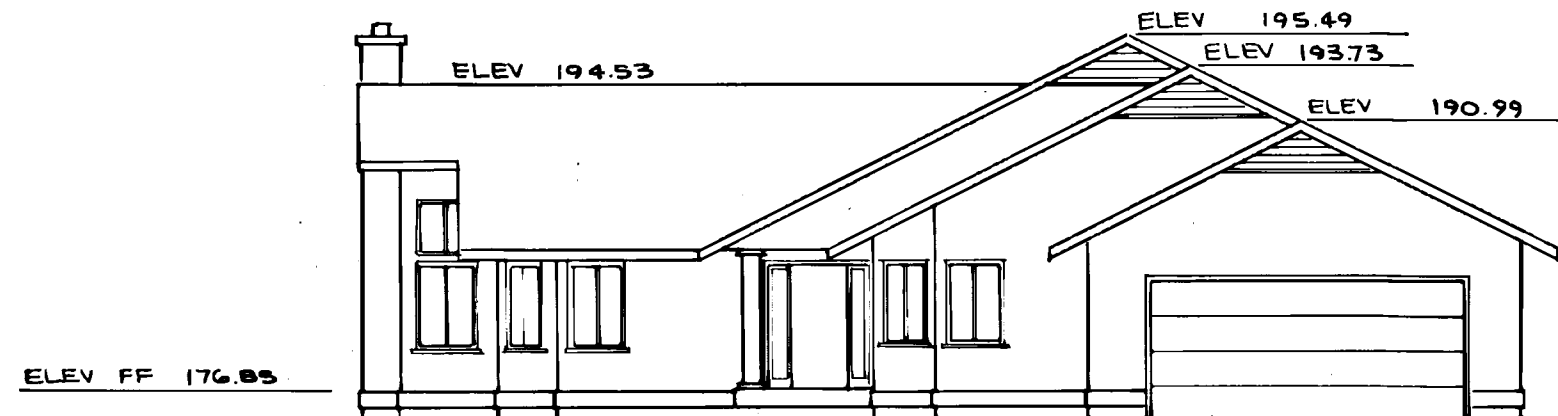

FRONT ELEVATION

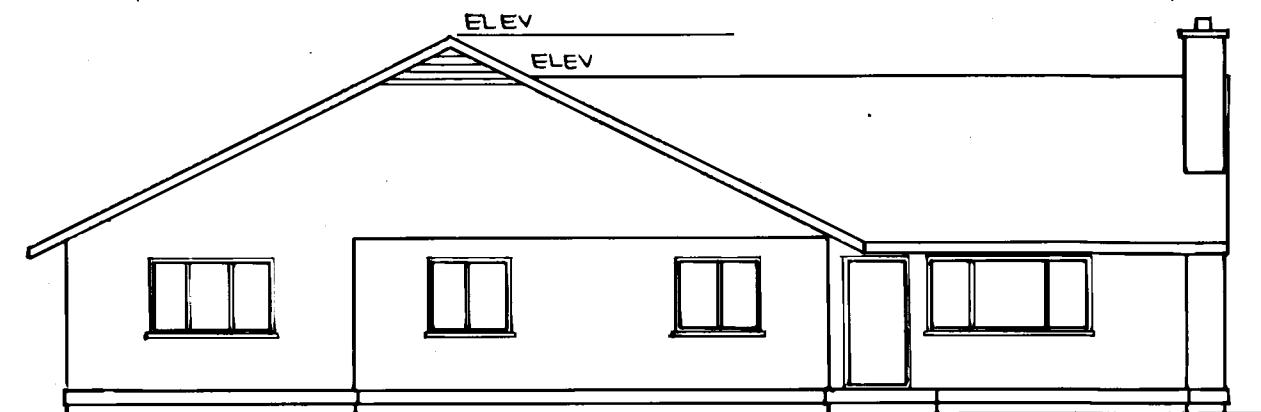

REAR ELEVATION

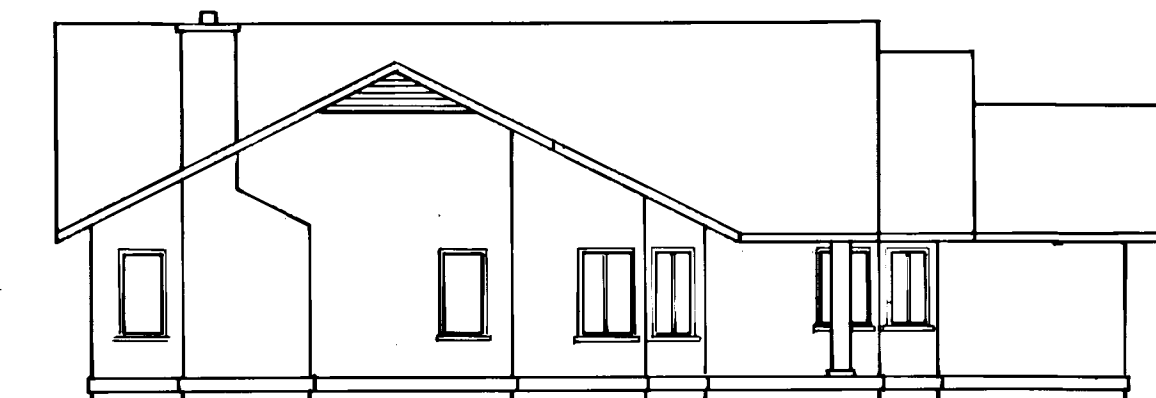

LEFT ELEVATION

901030215

VILLAGE AT CORDATA · NORTH SIDE · PHASE I


A PORTION OF PARCEL 4

"CORDATA SPECIFIC BINDING SITE PLAN NO. 1"


SECTION 12, TOWNSHIP 38 NORTH, RANGE 2 EAST, W.M.

SCALE: 1" = 10'


BUILDING UNIT L18

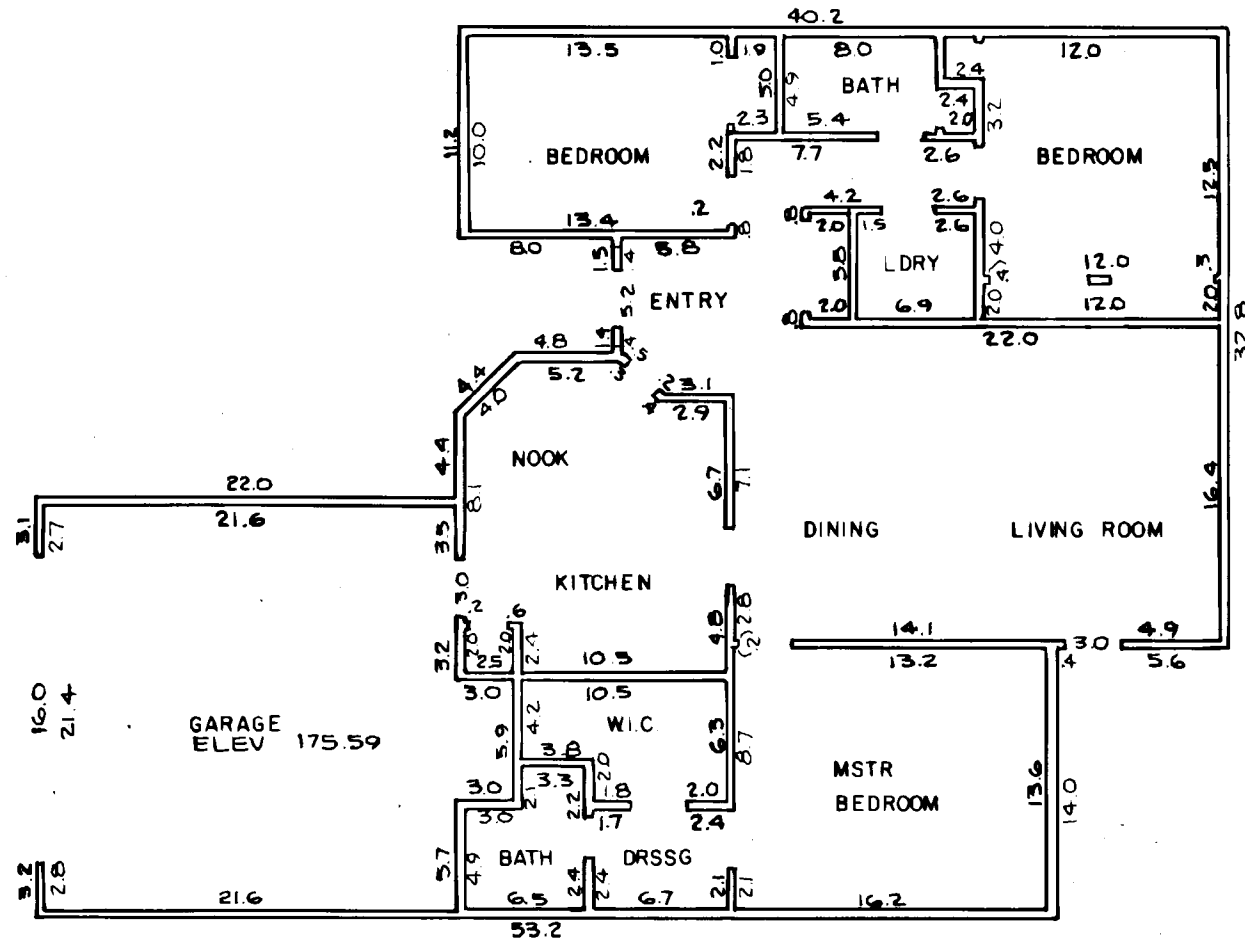


FLOOR PLAN

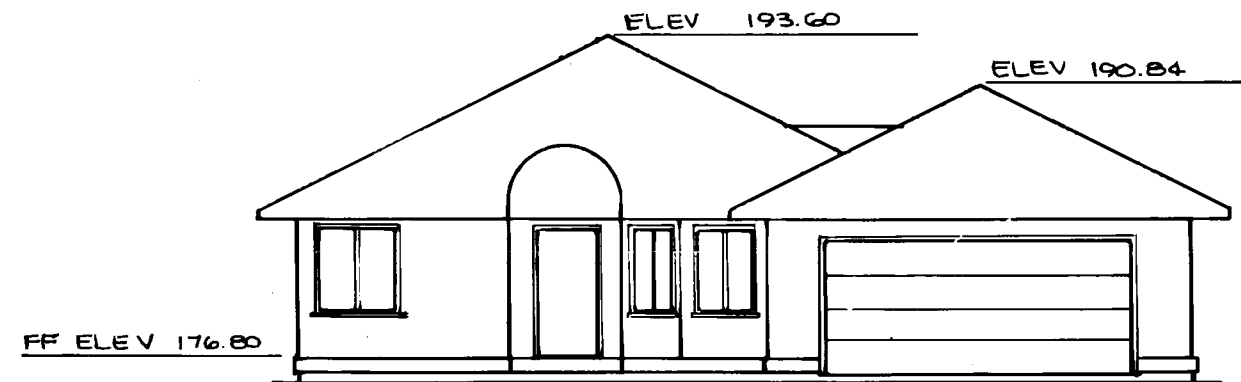


FRONT ELEVATION

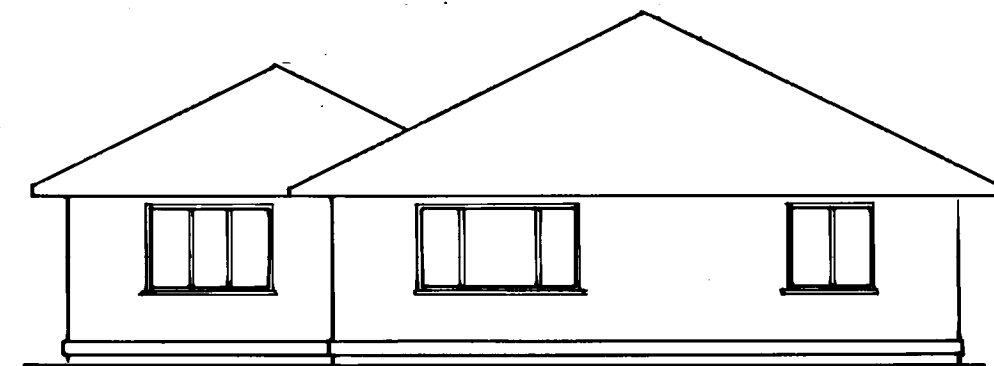

REAR ELEVATION

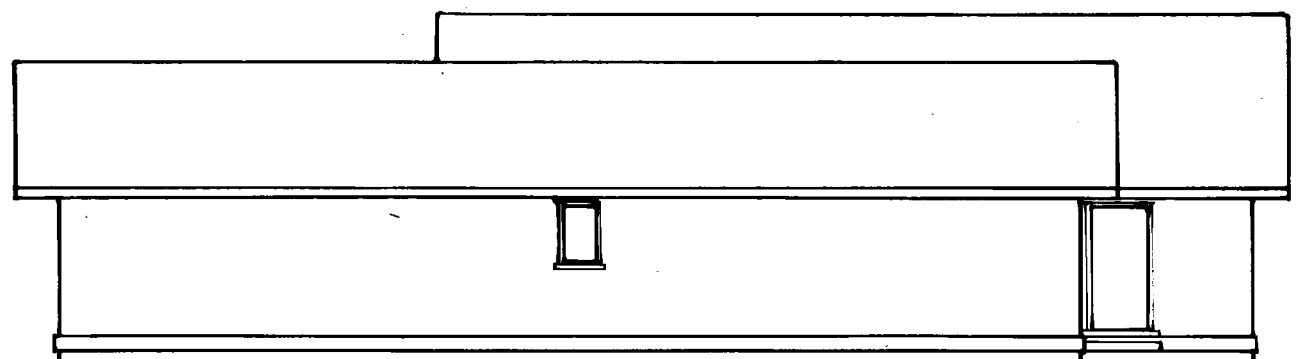

RIGHT ELEVATION

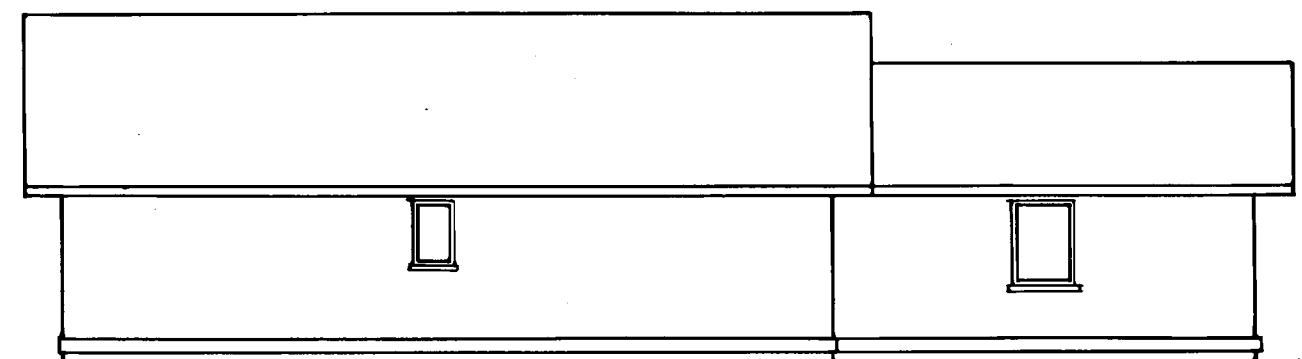

LEFT ELEVATION




901030215

VILLAGE AT CORDATA · NORTH SIDE · PHASE I


A PORTION OF PARCEL 4.

"CORDATA SPECIFIC BINDING SITE PLAN NO. 1"
SECTION 12, TOWNSHIP 38 NORTH, RANGE 2 EAST, W.M.
SCALE: 1" = 10'


BUILDING UNIT M19

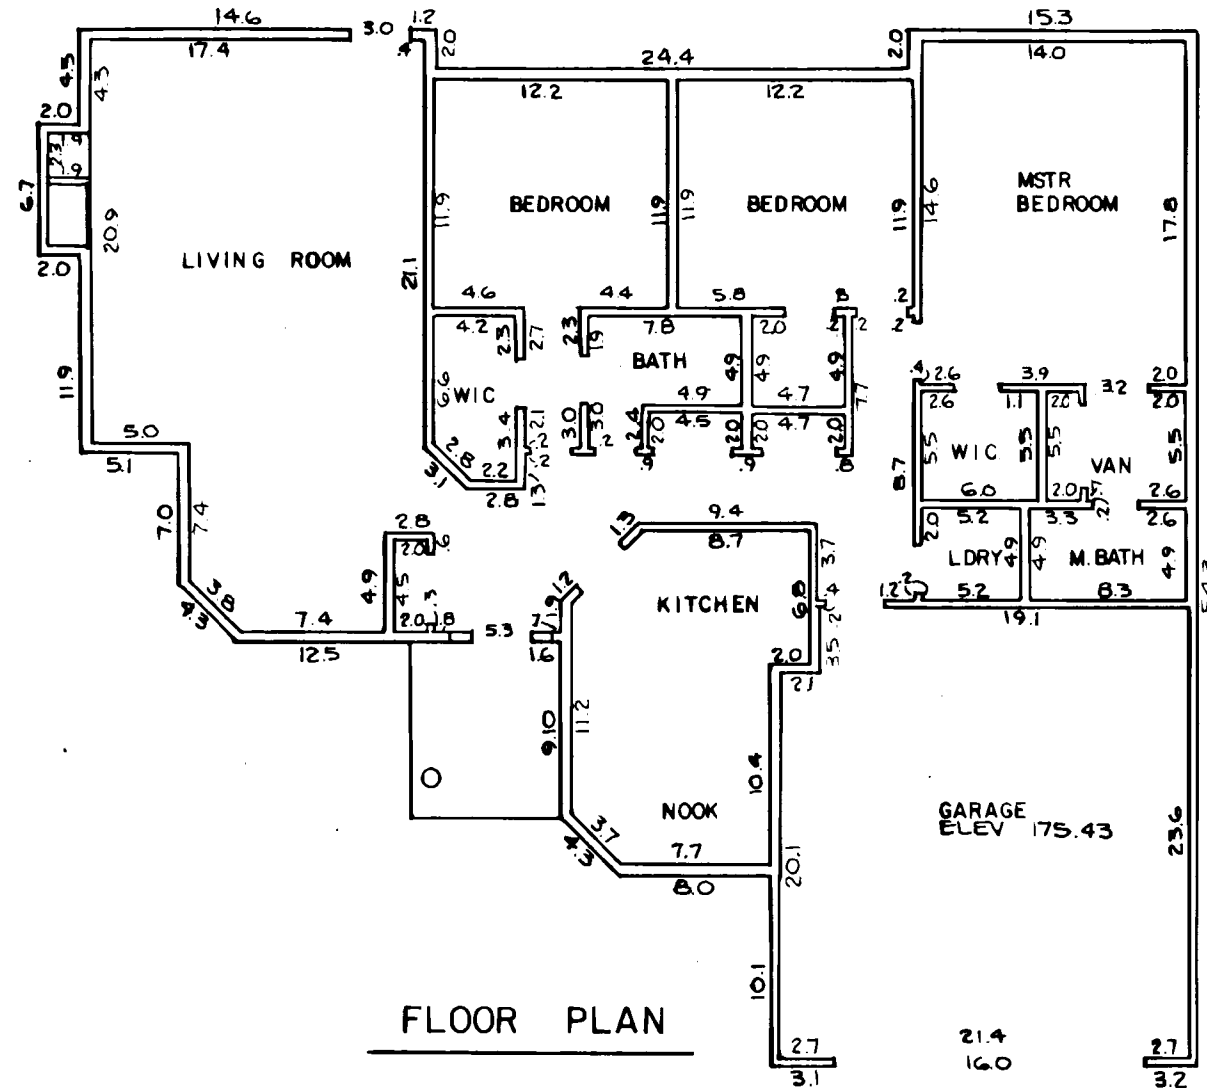


FLOOR PLAN

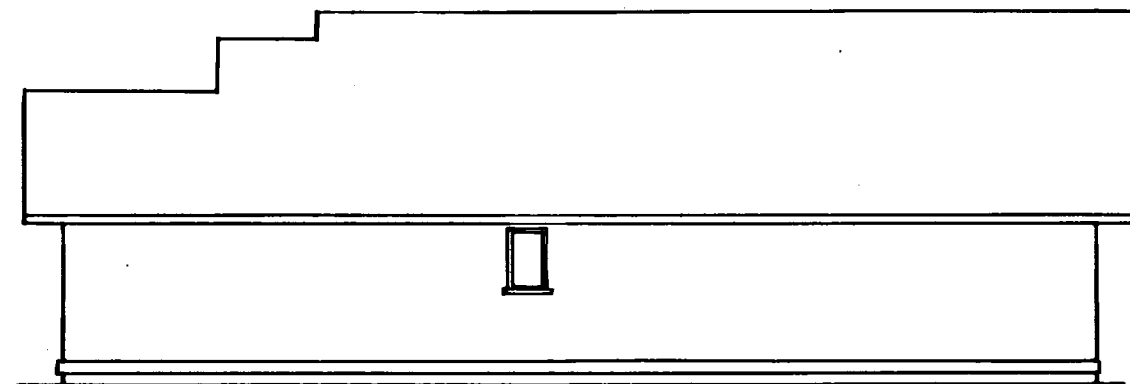


RIGHT ELEVATION

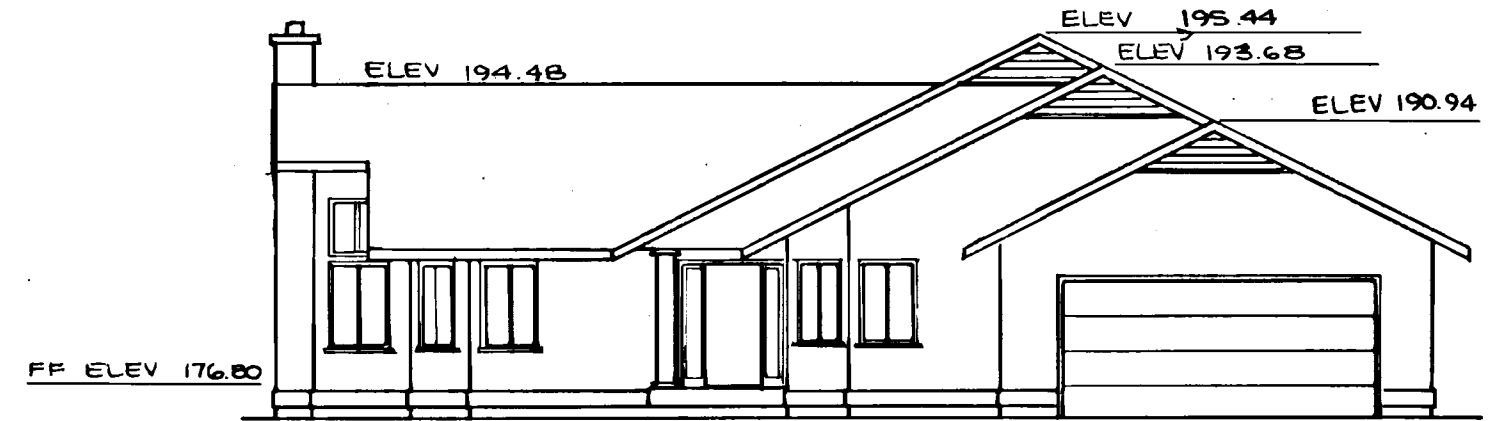

FRONT ELEVATION

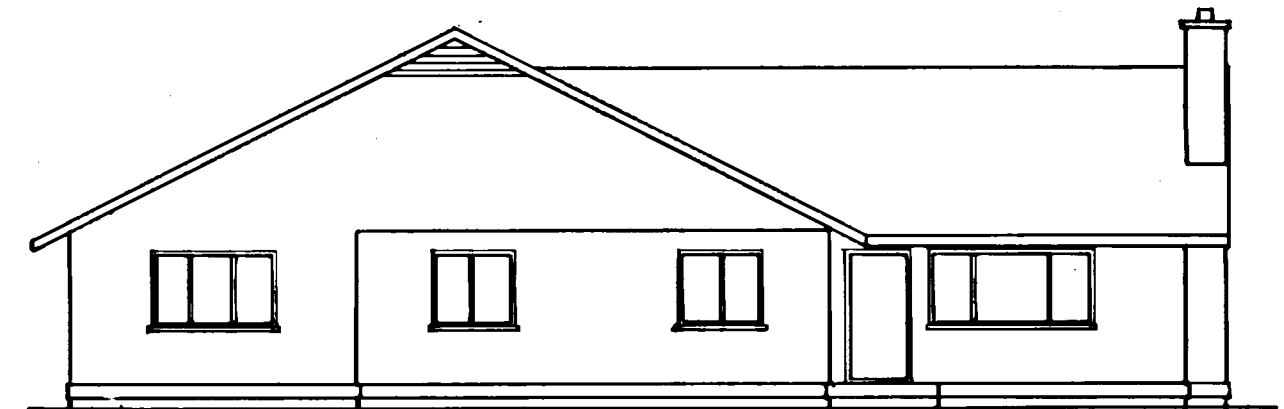

REAR ELEVATION

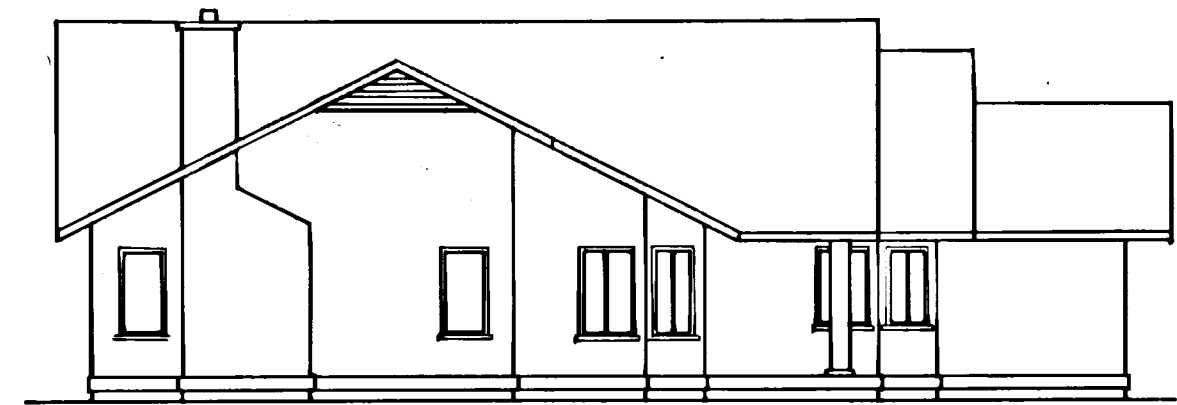

LEFT ELEVATION

901030215

VILLAGE AT CORDATA · NORTH SIDE · PHASE I


A PORTION OF PARCEL 4

"CORDATA SPECIFIC BINDING SITE PLAN NO. 1"

SECTION 12, TOWNSHIP 38 NORTH, RANGE 2 EAST, W.M.

SCALE: 1" = 10'


BUILDING UNIT L20

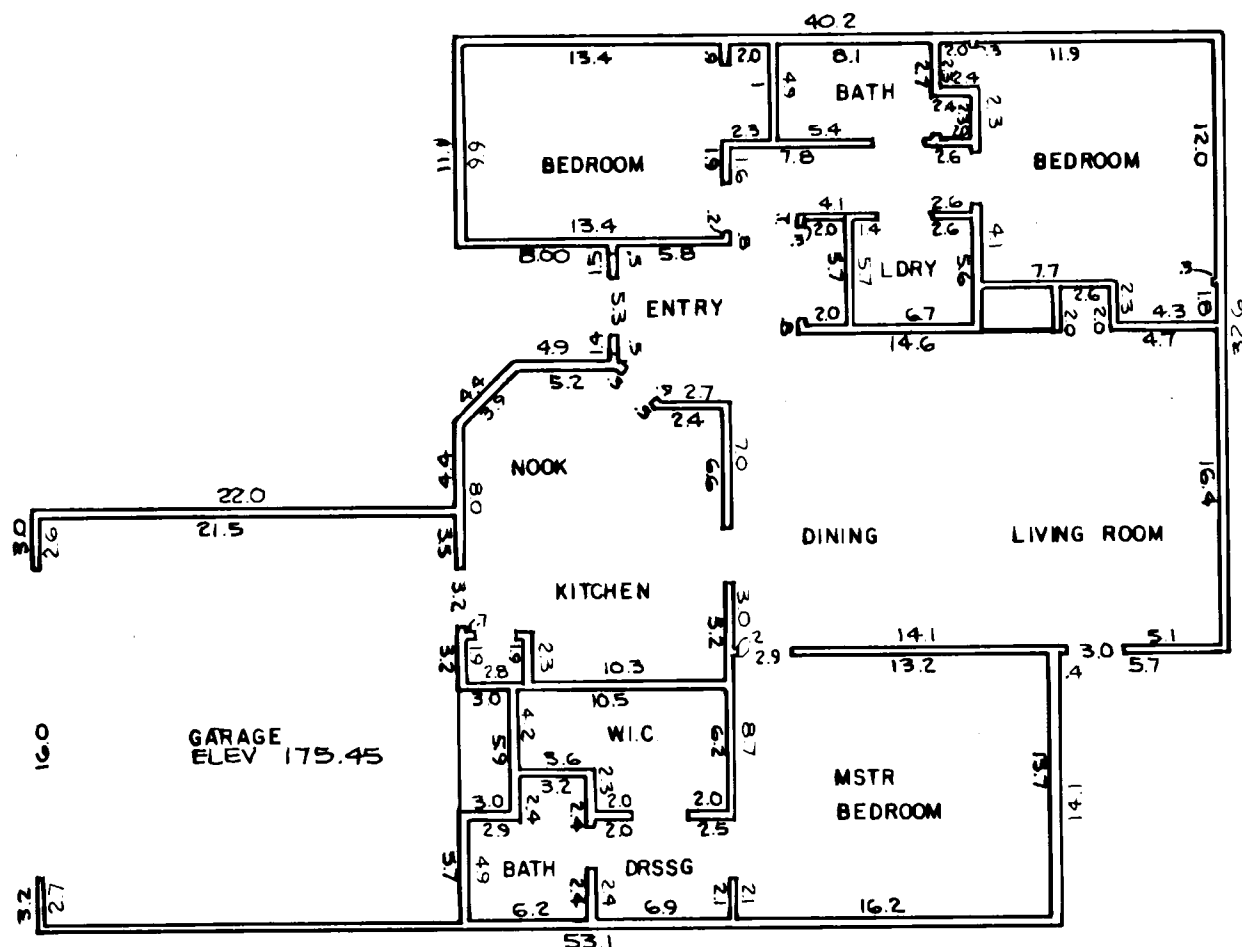


FLOOR PLAN




FRONT ELEVATION

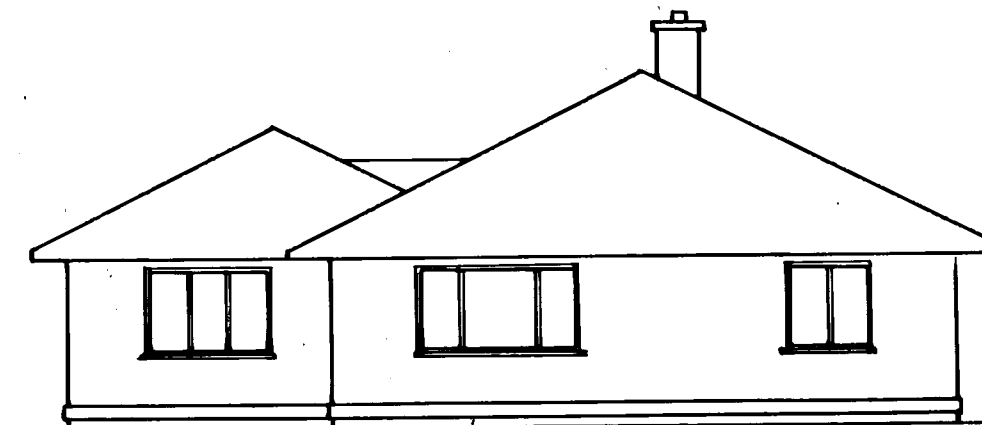

REAR ELEVATION

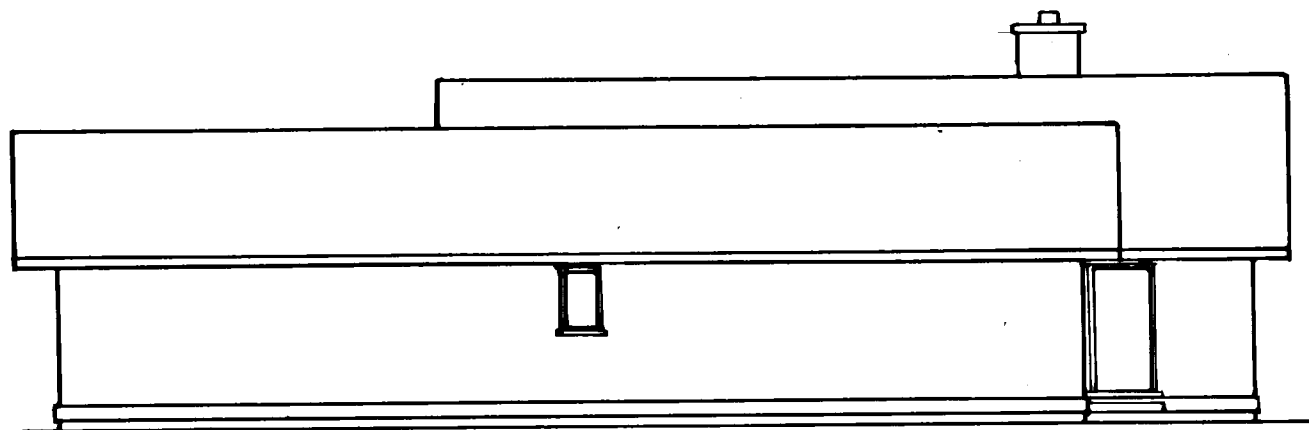

RIGHT ELEVATION

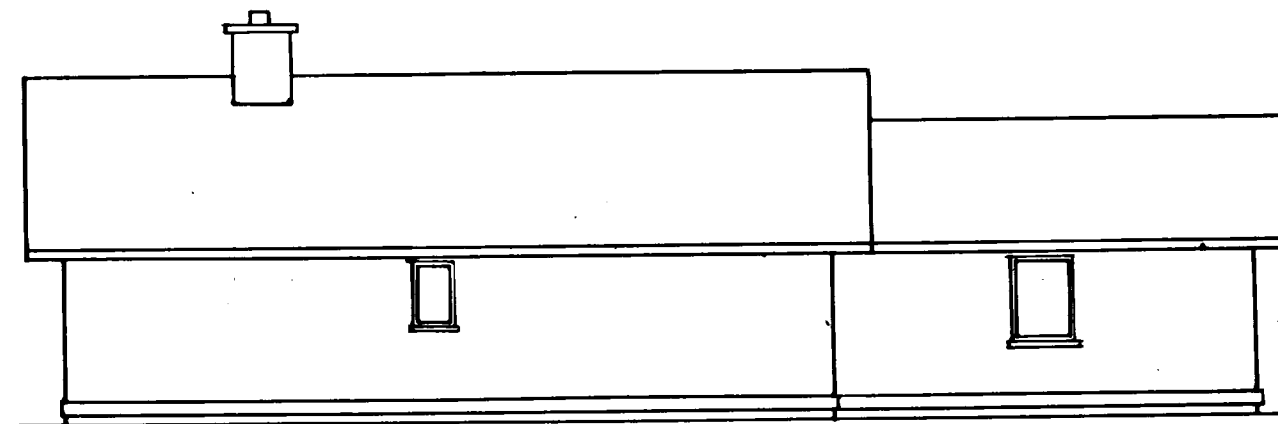

LEFT ELEVATION



901030215

VILLAGE AT CORDATA · NORTH SIDE · PHASE I


A PORTION OF PARCEL 4

"CORDATA SPECIFIC BINDING SITE PLAN NO. 1"


SECTION 12, TOWNSHIP 38 NORTH, RANGE 2 EAST, W.M.

SCALE: 1" = 10'


BUILDING UNIT L21

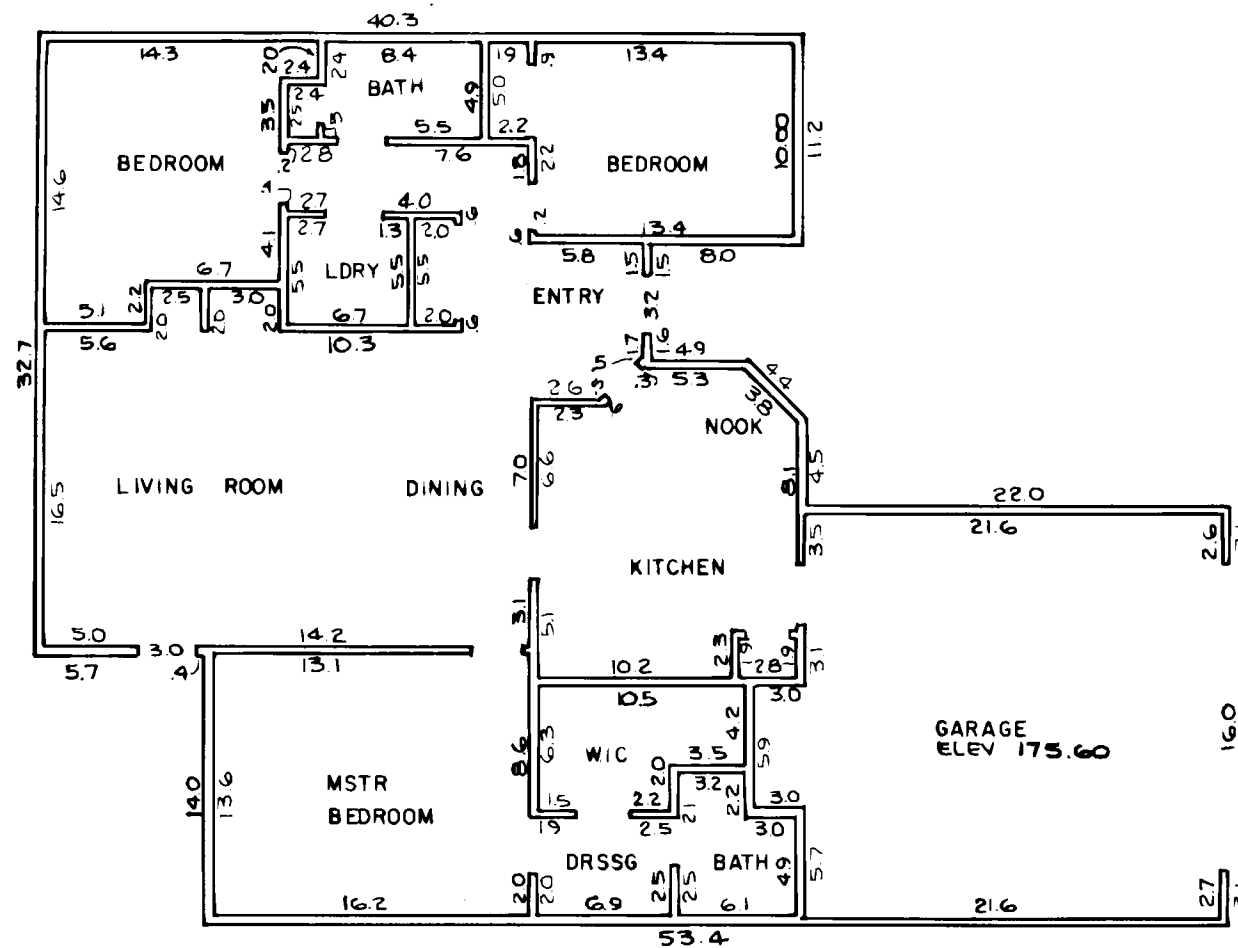


FLOOR PLAN

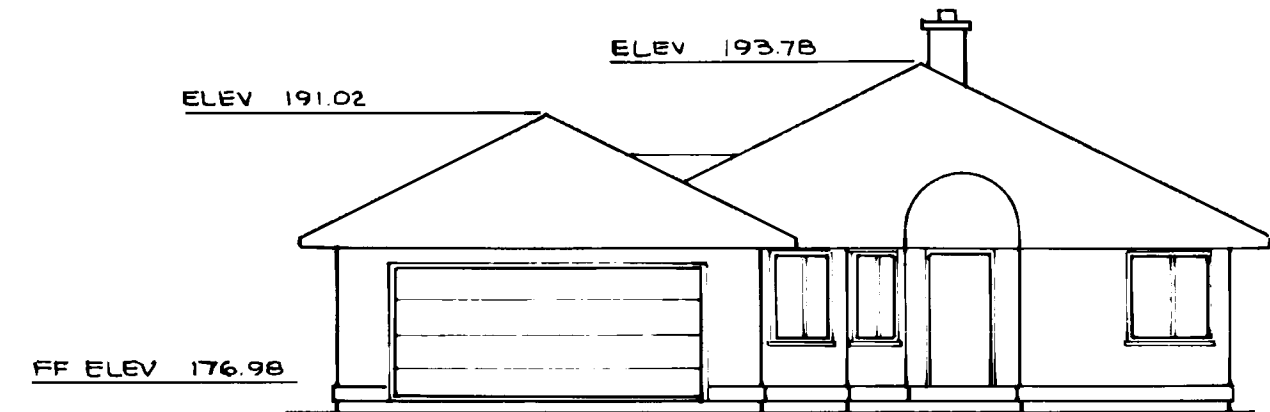


FRONT ELEVATION

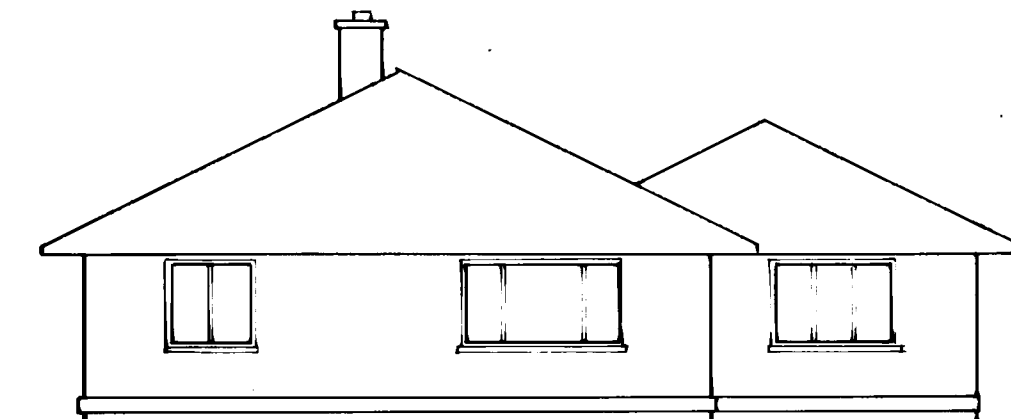

REAR ELEVATION

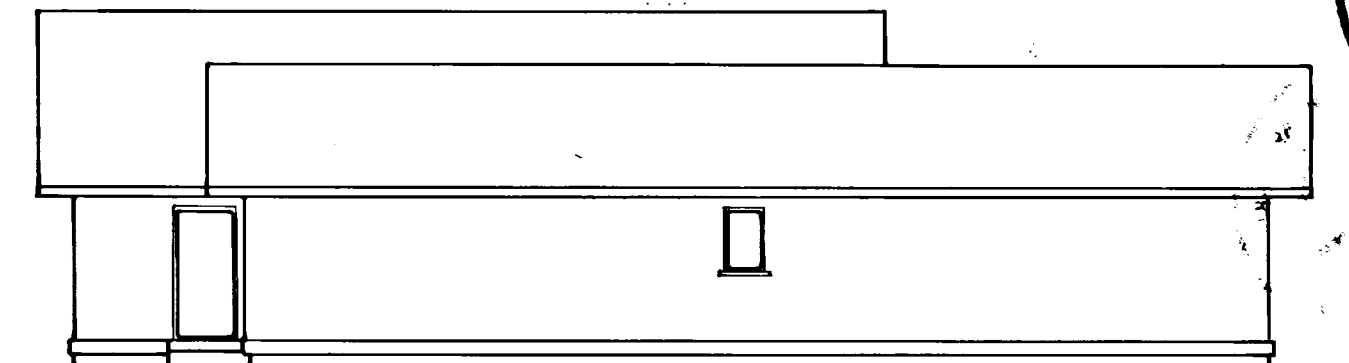

LEFT ELEVATION

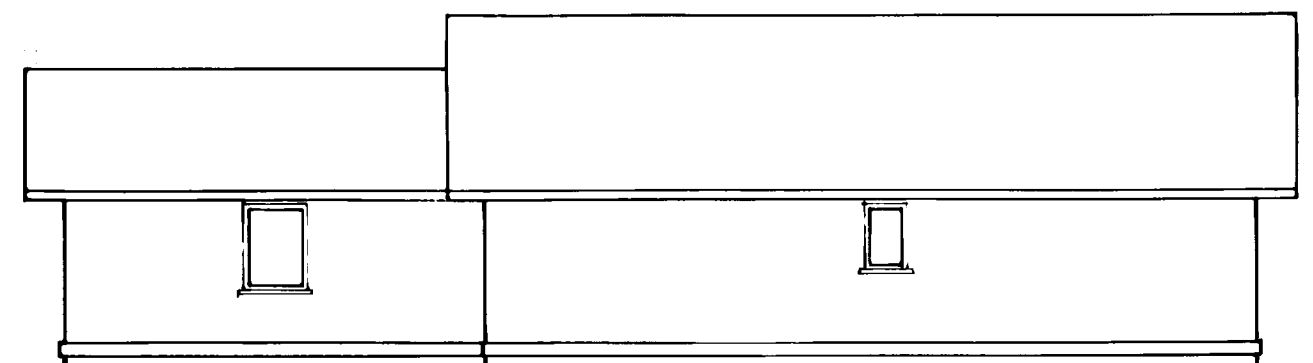

RIGHT ELEVATION

